

Colorado Interstate Gas


LEASE: Young # 13
FIELD: Young
COUNTY: Morgan
STATE: Colorado
LOCATION: 14 4N 58W
API #: 05-087- 06179-01
SPUD DATE: 01/07/1959
Rev. Date 7/31/2015 Lively

Current 9/1/2015

ELEVATION: 4552' KB: 0

TD: 6004' GL PBTD: 5979' GL

Size	ID
8-5/8	8.097
5-1/2	4.95

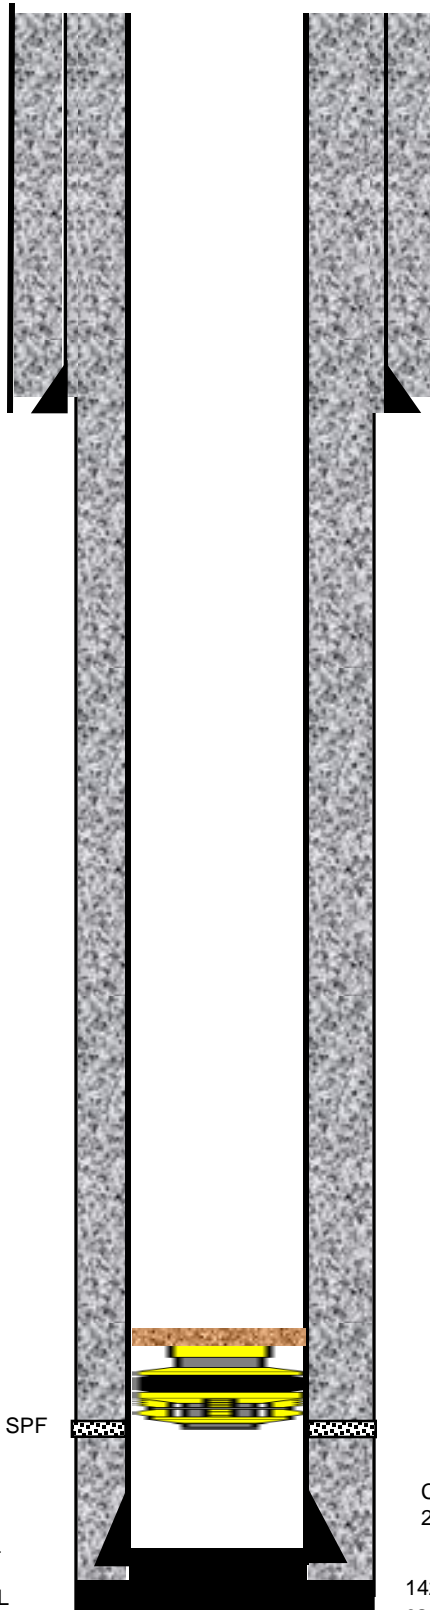

← 8-5/8", 24#, J55 casing set at 64' GL

Hole size and depth estimated from original plugging report

Retrievable Bridge plug, ZWPA, set at 5780 GL
Set 7/26/2015. hole loaded with water also.

Perfs 5892' – 5903' GL w/ 2 SPF

PBTD @ 5979' GL

TD 7-7/8" hole @ 6004' GL

30# of sand on top of Retrievable Bridge plug

Cemented w/ 1075 sxs HLC followed by 250 sxs 50/50 Poz. Cmt Circ.

142 jts, 5-1/2", 15.5#, K55, 8R, LT&C casing set at 6004' GL