| | | | | | |
|---|---|---|---|---|---|
| **API:** | **05-123-08716** | **KB ELEVATION:** | **5028'** | **QTR-QTR:** | **NWNE** |
| **WELL NAME:** | **Grant Brothers 31-11 2** | **GROUND LEVEL:** | **5018'** | **SECTION:** | **11** |
| **COUNTY:** | **WELD** | **MD:** | **5270'** | **TWNSHIP:** | **1N** |
| **LATITUDE:** | **40.07126** | **PBMD:** | **5237'** | **RANGE:** | **68W** |
| **LONGITUDE:** | **-104.96815** | **CREATED BY:** | **Kevin Kuzio** | | |
| | | **DATE:** | 9/1/2015 | | **FINAL** |

DATUM: RKB
KB=10'

| | | | | |
|---|---|---|---|---|
| Hole Size/Depth | 12 1/4" - 621' | | | |
| Surface Casing | | | | |
| Casing Size/Depth: 8 5/8, 24#/ft @ | | 616' | 420' | TOC tagged |
| Fox Hills Formation Marker | | 1143' | 873' | TOC tagged |
| | | | 1245' | Shoot off casing |
| | | | 1365' | BOC inside csg |
| | | | 4000' | TOC in csg |
| | | | 4175' | Squeeze perfs |
| | | | 4380' | Squeeze perfs |
| OH TOC (from CBL) | | 4470' | 4404' | TOC inside casing (tagged) |
| Sussex Top | 4534' | | 4534' | BOC inside casing |
| Sussex Perfs | 4658' - 4701' | | | |
| Sussex Base | 4778' | | | |
| Shannon Perfs | 5144' - 5160' | | | |
| Shannon Base | 5256' | | | |
| Production Casing/Hole | | | | |
| Casing Size/Depth | 5 1/2'' x 15.5#/ft @ | 5267' | | |
| Hole Size/Depth | 7 7/8" (bit size) @ | 5270' | | |

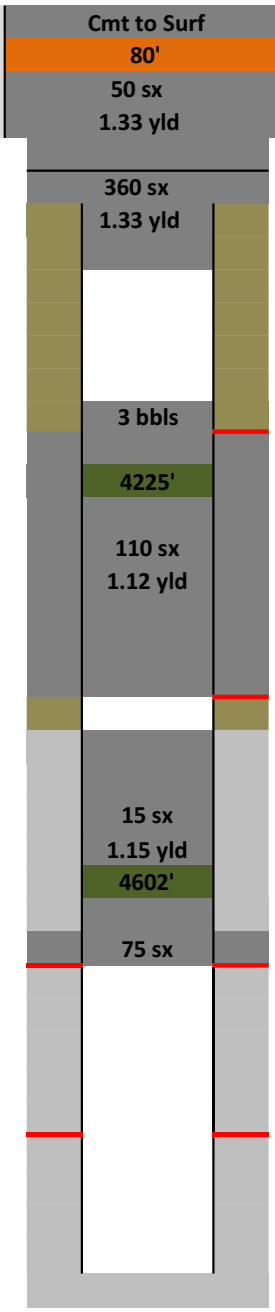


| |
|---|
| Existing Cement |
| New CICR |
| Existing CICR |
| New CIBP |
| Existing CIBP |
| New Cement |
| Sand Plug |
| Existing Mud |