

Current Wellbore Diagram




Daily Operations Report Wellbore Diagram

Well Name:	BW Musser 21
County, State	Moffat, CO
Legal Description:	NE NE 9-11N-97W
API:	05-081-06229
SHL:	660 FNL, 659' FEL
BHL Relative to SHL:	0' N, 0' E
Updated By:	Scott Colvin
Date Updated:	11/7/2013
Spud Date:	7/5/1974
TD Date:	7/31/1974
IP Date:	9/30/1974
Well TD:	7,151
Well TVD:	7,151
Orientation:	Vertical
Plug Back MD:	6,110
Bridge Plug MD:	
Producing Frac Jobs:	1

Latitude	40.933261
Longitude	-108.289408

As Of WO	12/2/2013
----------	-----------

All measurements are in KB
unless otherwise specified.

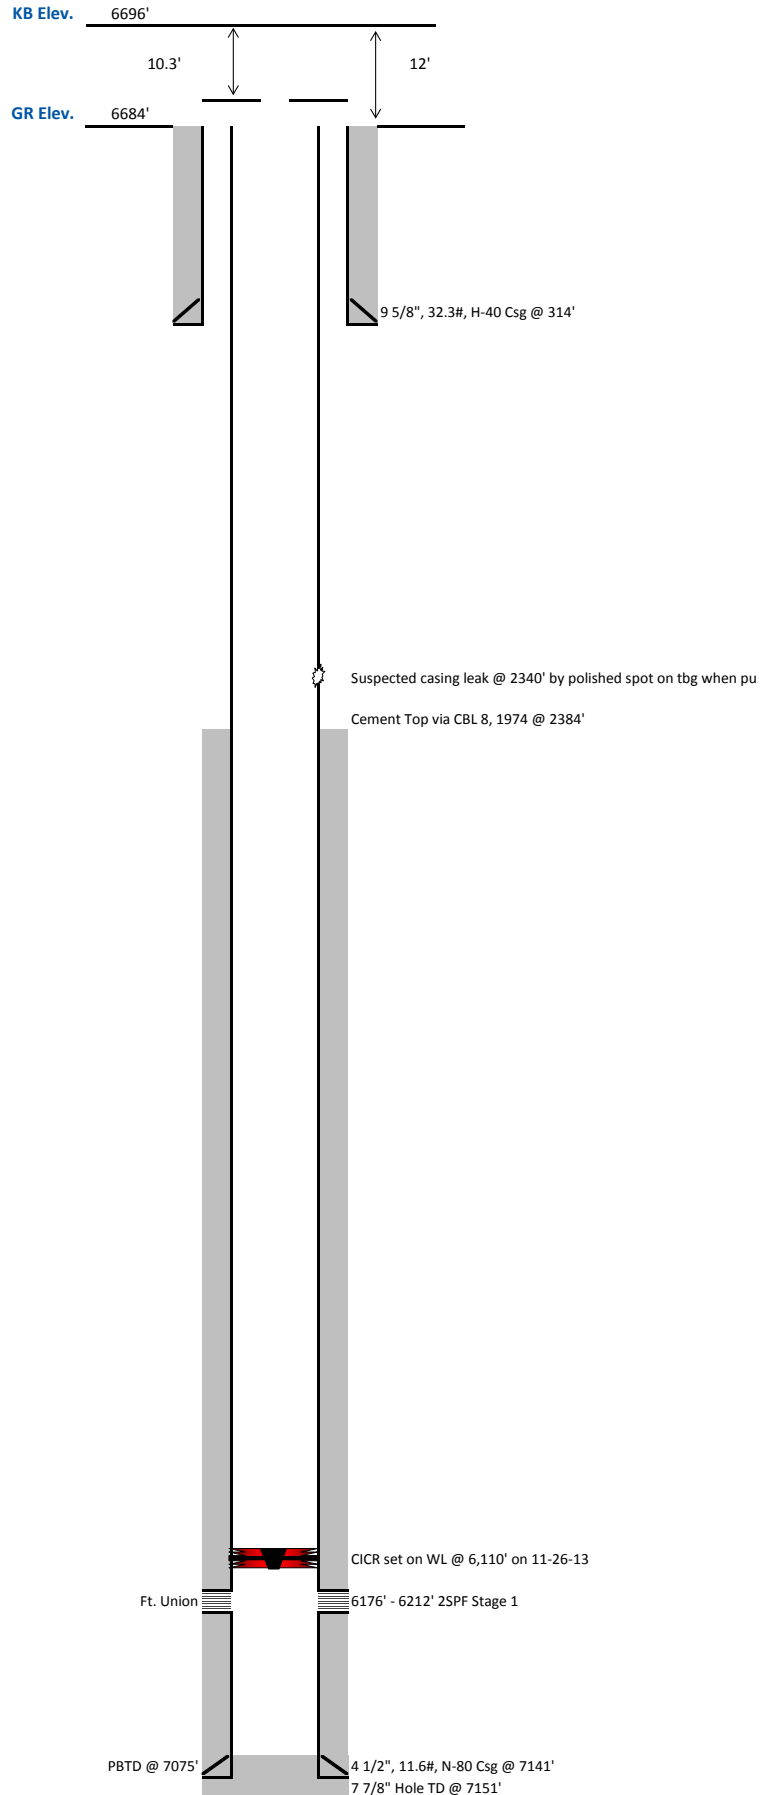

Proposed Wellbore Diagram



Daily Operations Report Wellbore Diagram

Well Name:	BW Musser 21
County, State	Moffat, CO
Legal Description:	NE NE 9-11N-97W
API:	05-081-06229
SHL:	660 FNL, 659' FEL
BHL Relative to SHL:	0' N, 0' E
Updated By:	Jeff Bluemel
Date Updated:	9/4/2015
Spud Date:	7/5/1974
TD Date:	7/31/1974
IP Date:	9/30/1974
Well TD:	7,151
Well TVD:	7,151
Orientation:	Vertical
Plug Back MD:	Surface
Bridge Plug MD:	
Producing Frac Jobs:	None

Latitude	40.933261
Longitude	-108.289408

As Of Plug & Abandon	Pending
----------------------	---------

All measurements are in KB
unless otherwise specified.

