

# **PDC ENERGY**

**WELD COUNTY, COLORADO  
SE SE SEC. 18 T4N R67W 6th P.M.  
RIEDER 18T-221  
JOB # 2015-044-135**

**20 June, 2015**

**Survey: FINAL SURVEYS**









Project: WELD COUNTY, COLORADO  
Site: SE SE SEC. 18 T4N R67W 6th P.M.  
Well: RIEDER 18T-221  
Wellbore: JOB # 2015-044-135  
Design: FINAL SURVEYS

| ANNOTATIONS |         |       |        |        |        |        |        |                             |  |
|-------------|---------|-------|--------|--------|--------|--------|--------|-----------------------------|--|
| TVD         | MD      | Inc   | Azi    | +N/-S  | +E/-W  | VSec   | Dep    | Annotation                  |  |
| 899.9       | 900.0   | 1.20  | 283.49 | 0.7    | -6.4   | 1.3    | 7.4    | SURFACE CASING              |  |
| 6371.6      | 6435.0  | 5.12  | 356.96 | -628.6 | -408.2 | -584.8 | 786.1  | KOP                         |  |
| 6980.9      | 7339.0  | 87.47 | 357.83 | -74.9  | -424.1 | -32.4  | 1338.4 | ICP                         |  |
| 6936.8      | 11491.0 | 91.30 | 2.10   | 4074.8 | -411.6 | 4095.6 | 5488.8 | LAST SURVEY - JUNE 19, 2014 |  |
| 6935.6      | 11543.0 | 91.30 | 2.10   | 4126.8 | -409.7 | 4147.1 | 5540.8 | EXTRAPOLATION TO TD         |  |

AS DRILLED LOCAL COORDINATES:  
  
SHL: 677ft FSL & 682ft FEL Sec 18  
  
7" ICP: 529.7ft FSL & 1106.1ft FEL Sec 18  
  
BHL: 500.8ft FNL & 917ft FEL Sec 18

| WELLBORE TARGET DETAILS (LAT/LONG) |        |        |        |           |             |       |
|------------------------------------|--------|--------|--------|-----------|-------------|-------|
| Name                               | TVD    | +N/-S  | +E/-W  | Latitude  | Longitude   | Shape |
| 7" ICP *NEW* - RIEDER 18-221 (P2)  | 6948.0 | -111.1 | -412.7 | 40.307545 | -104.927050 | Point |
| BHL - RIEDER 18T-221 (P2)          | 6936.0 | 4127.6 | -412.7 | 40.319180 | -104.927050 | Point |
| KOP - RIEDER 18T-221 (P2)          | 6391.4 | -639.1 | -412.7 | 40.306096 | -104.927050 | Point |

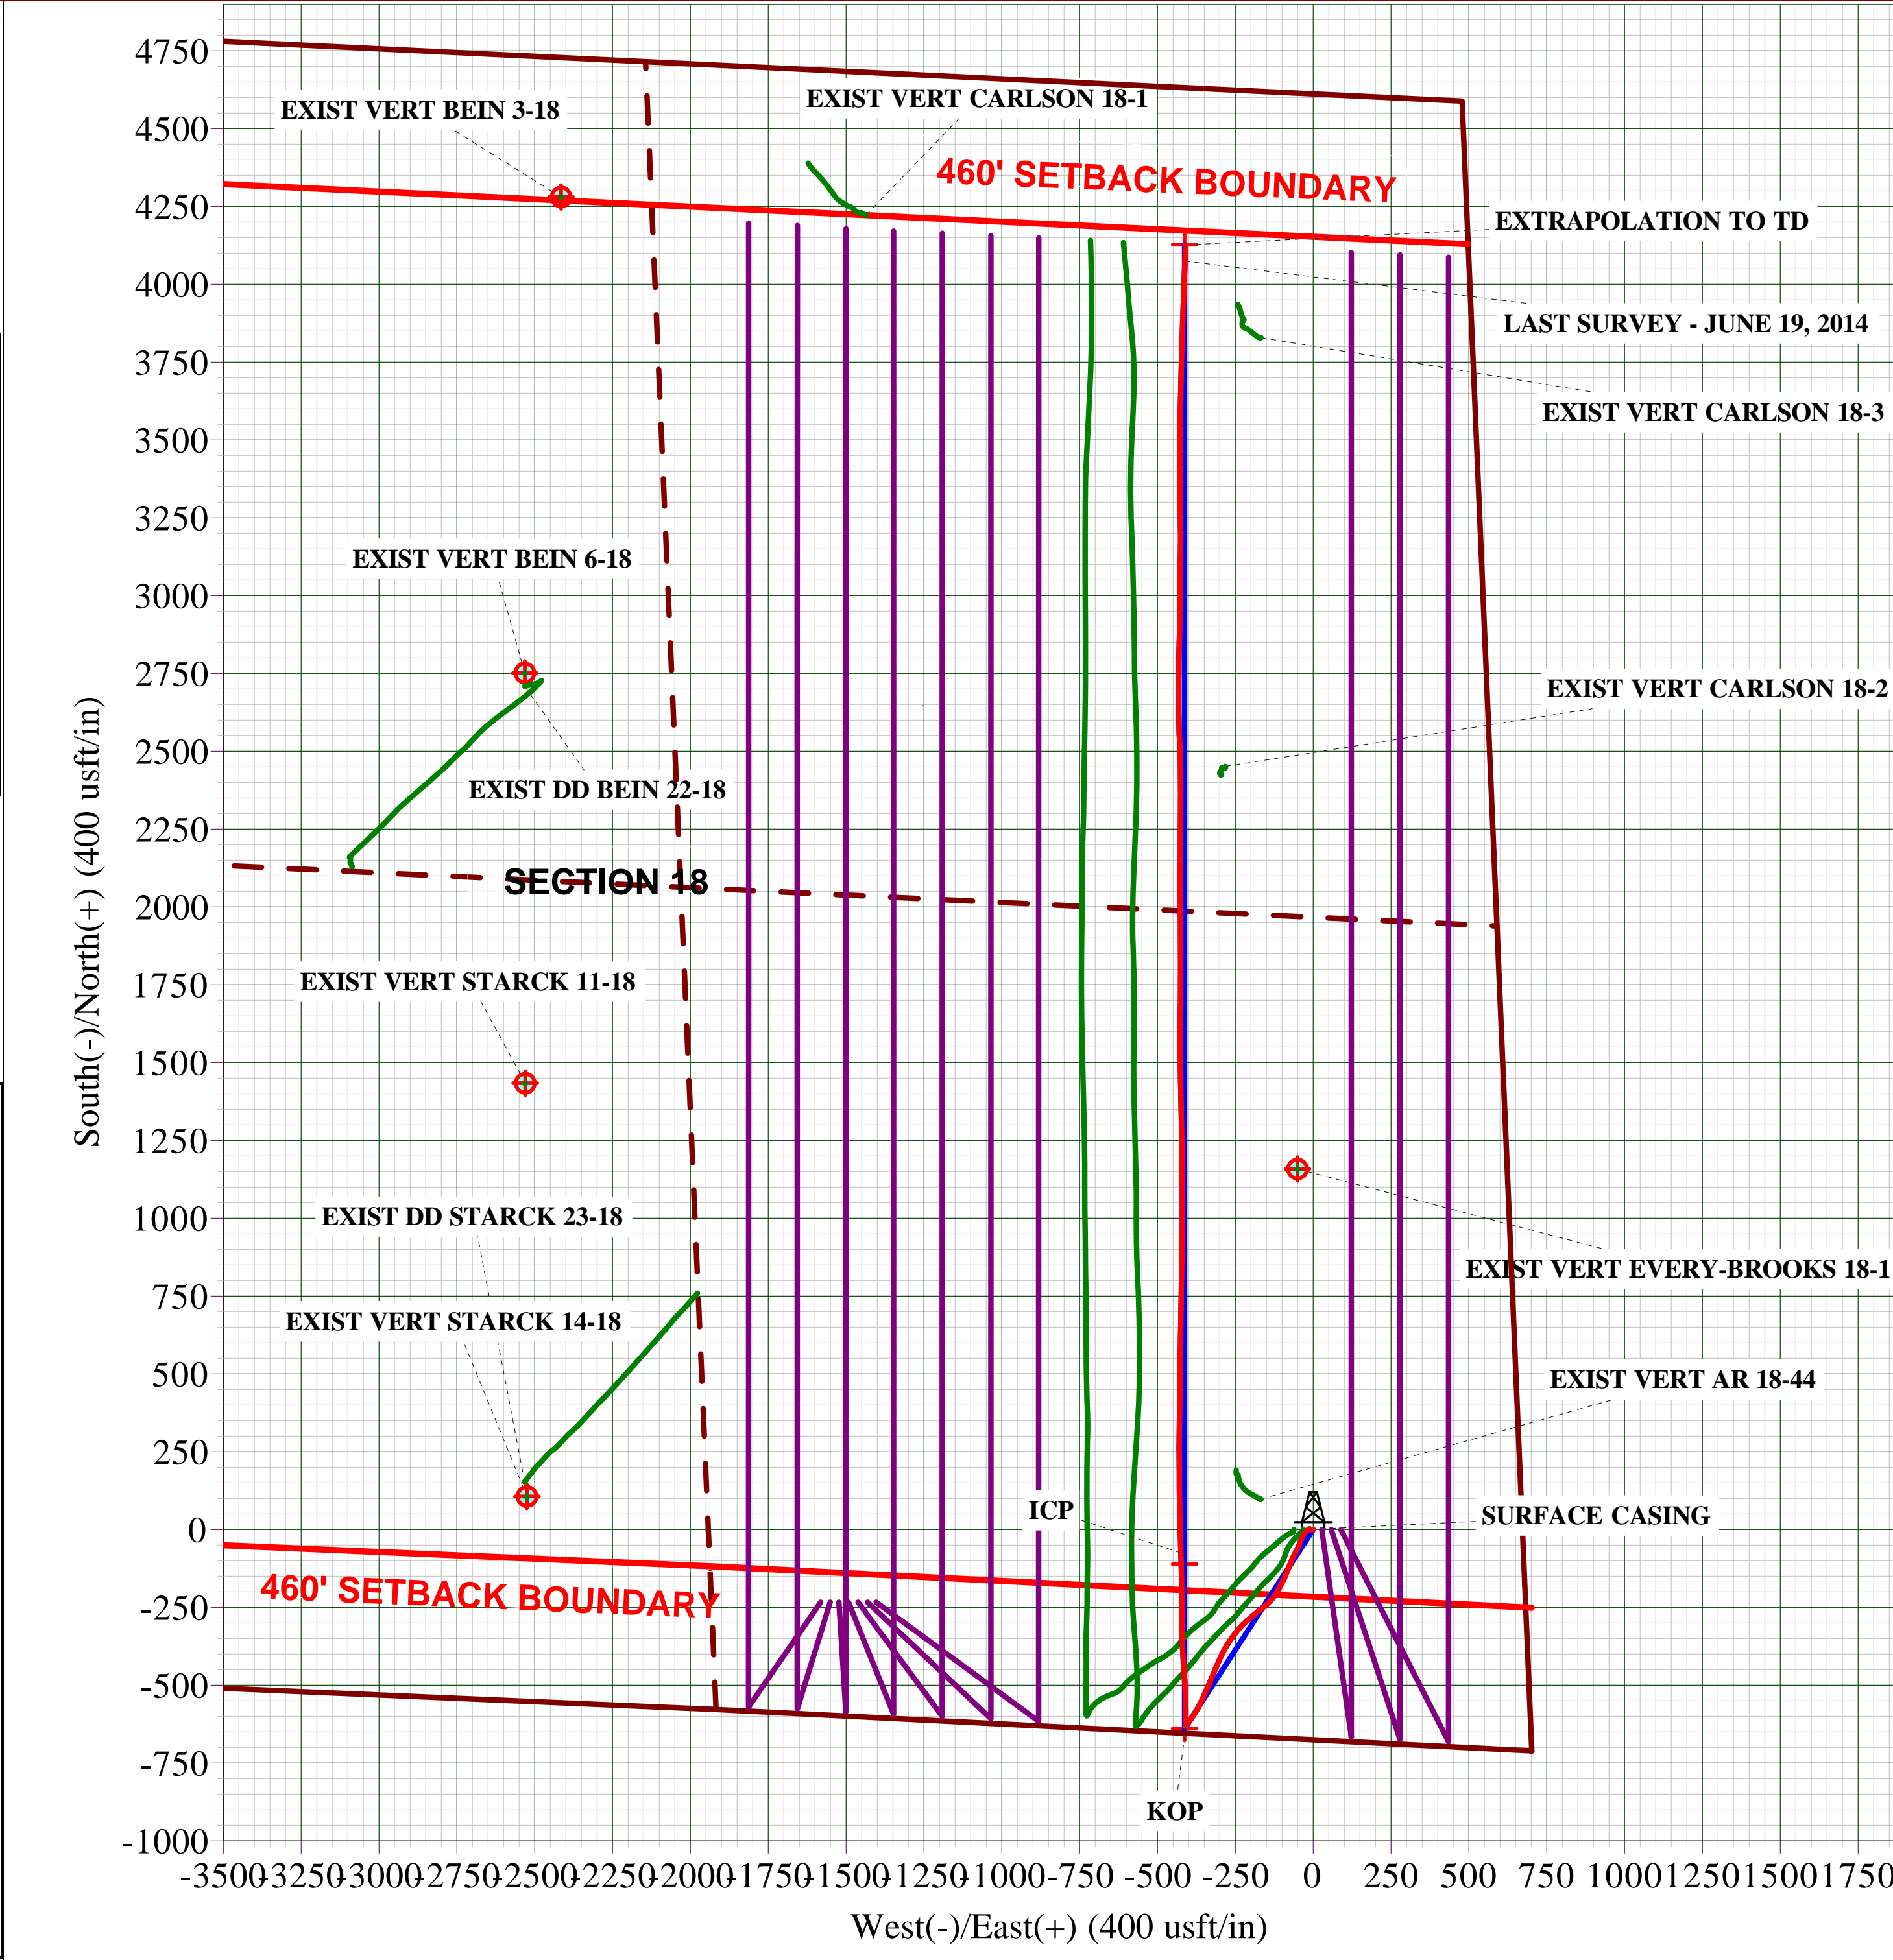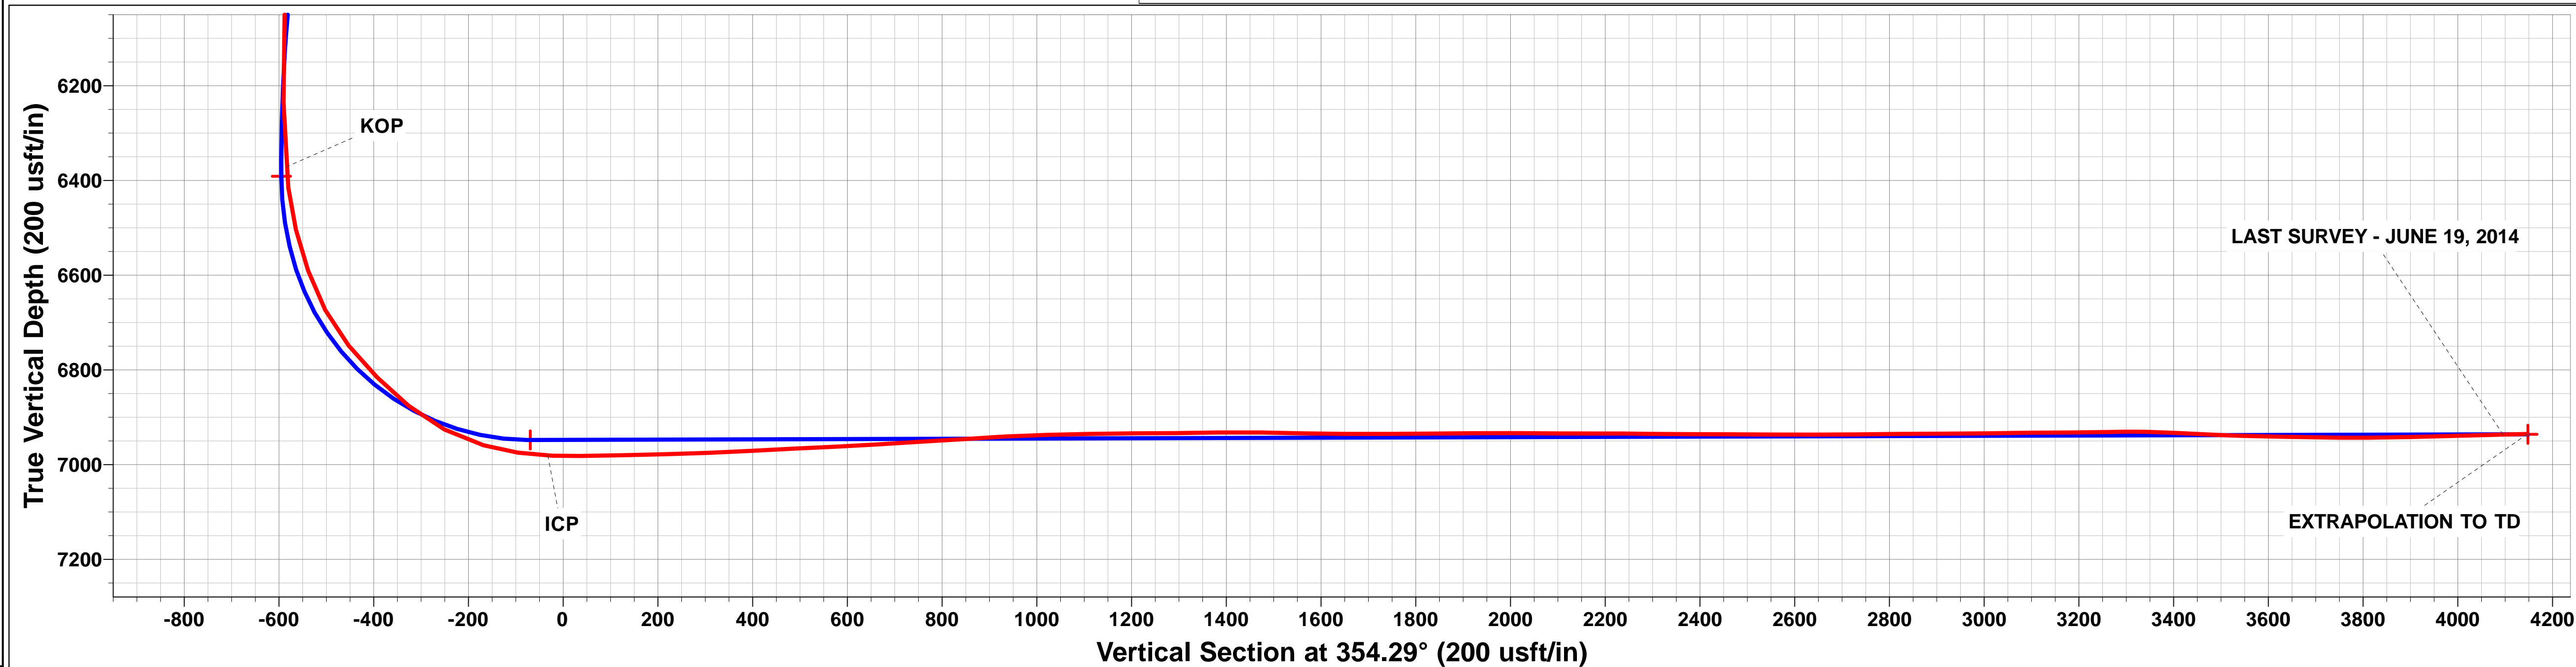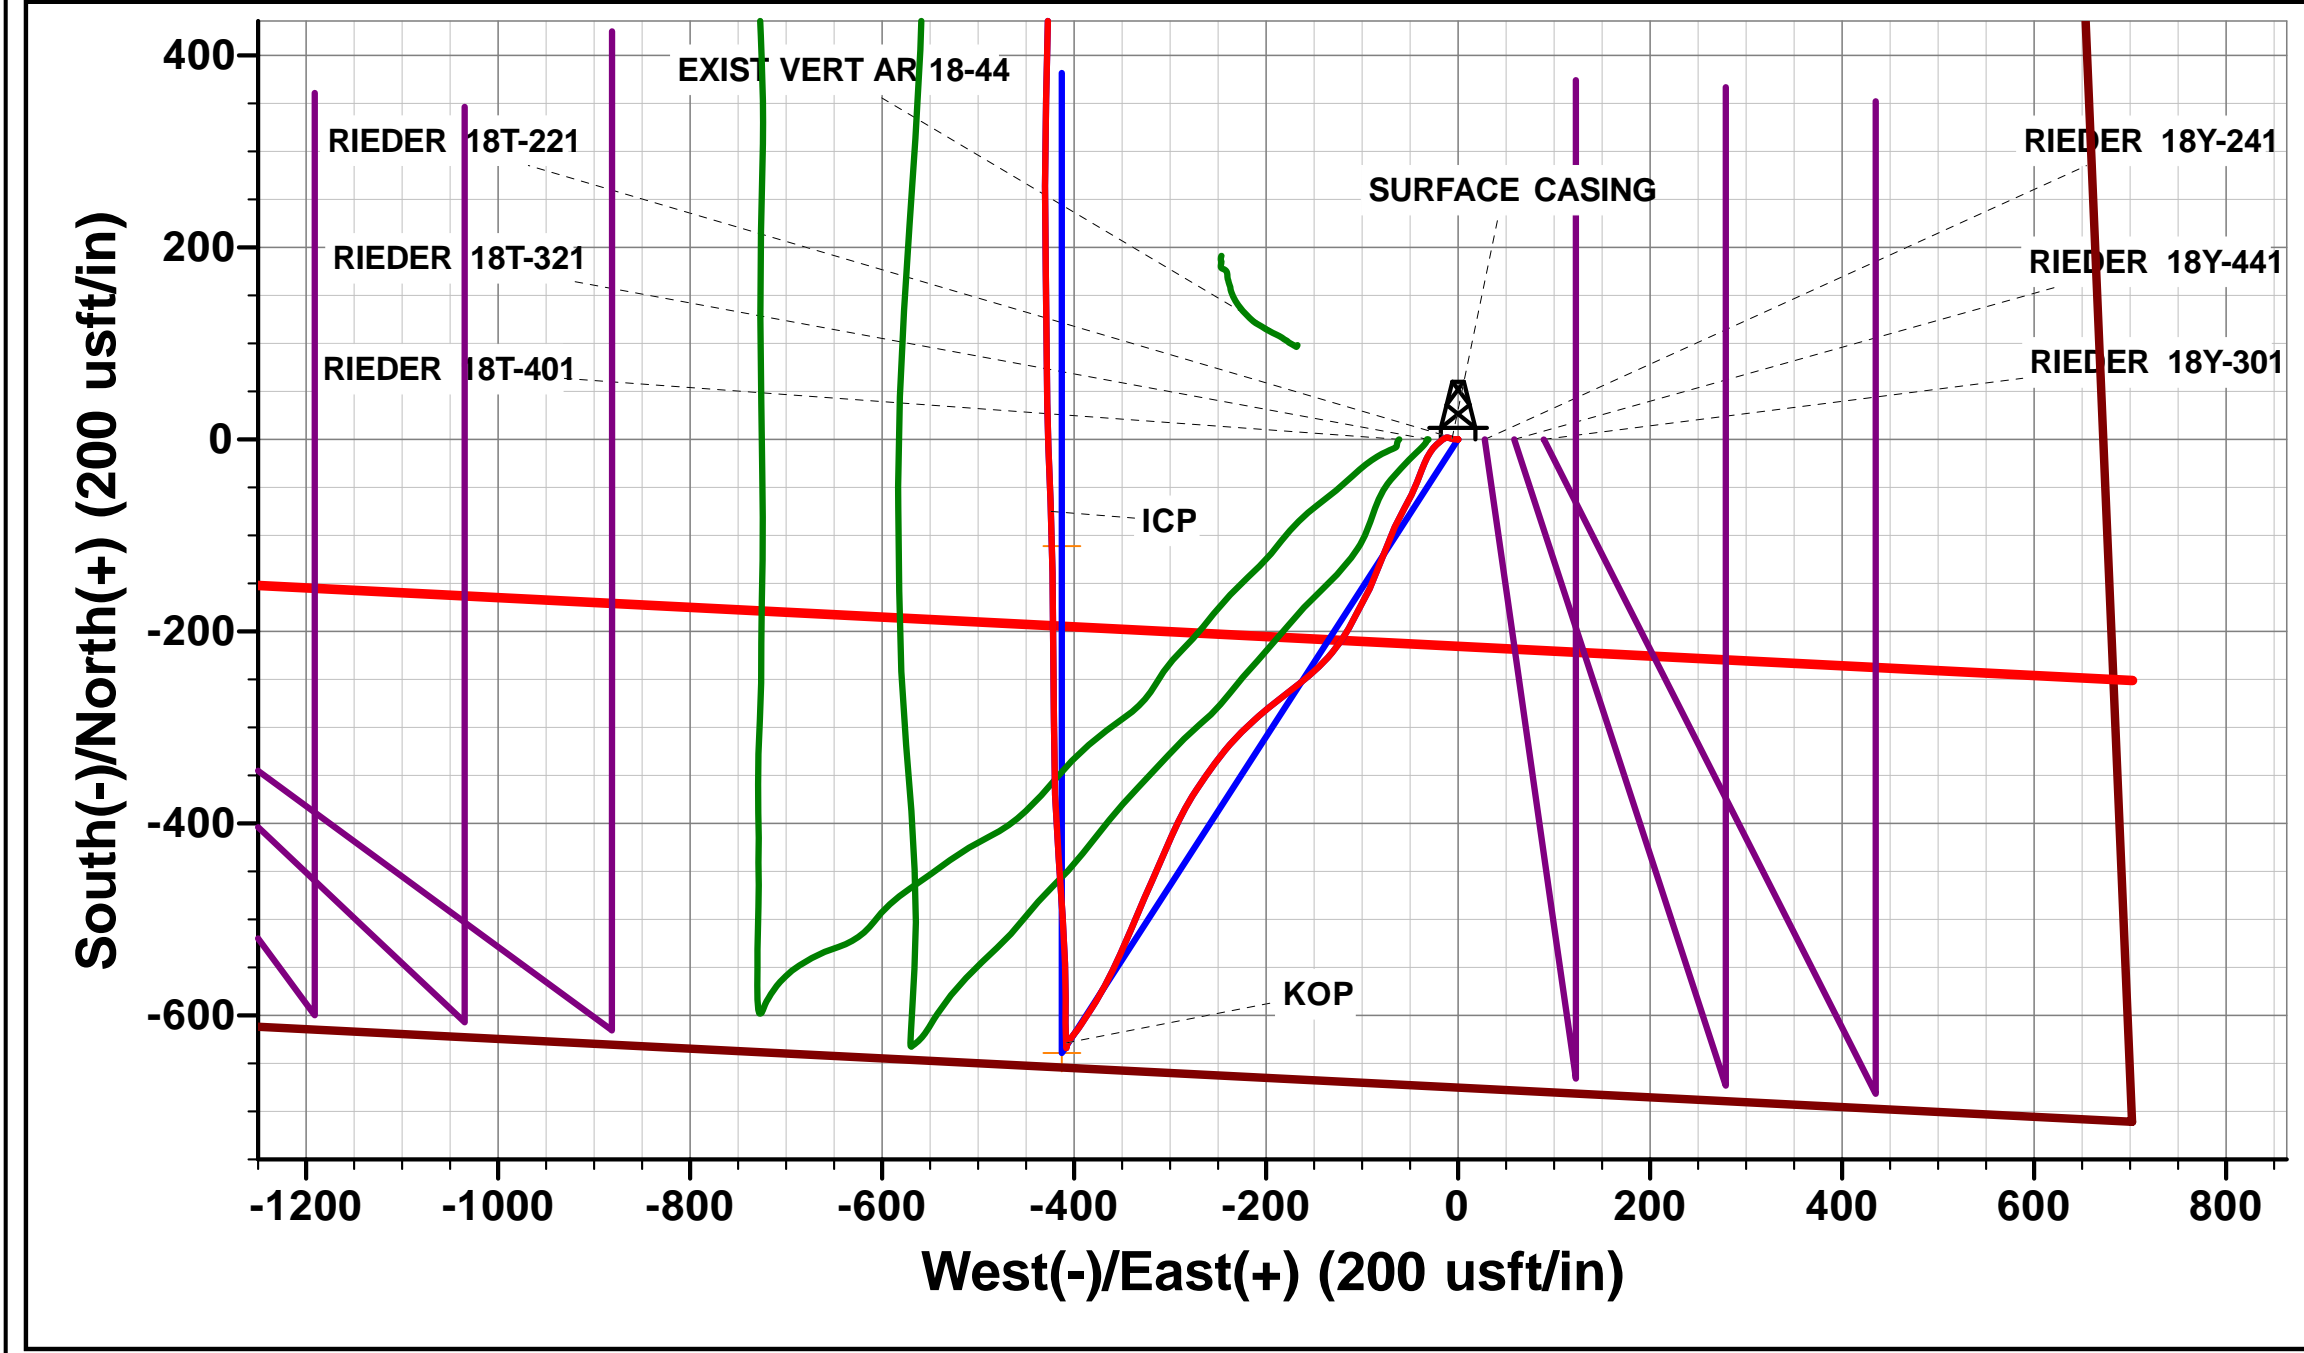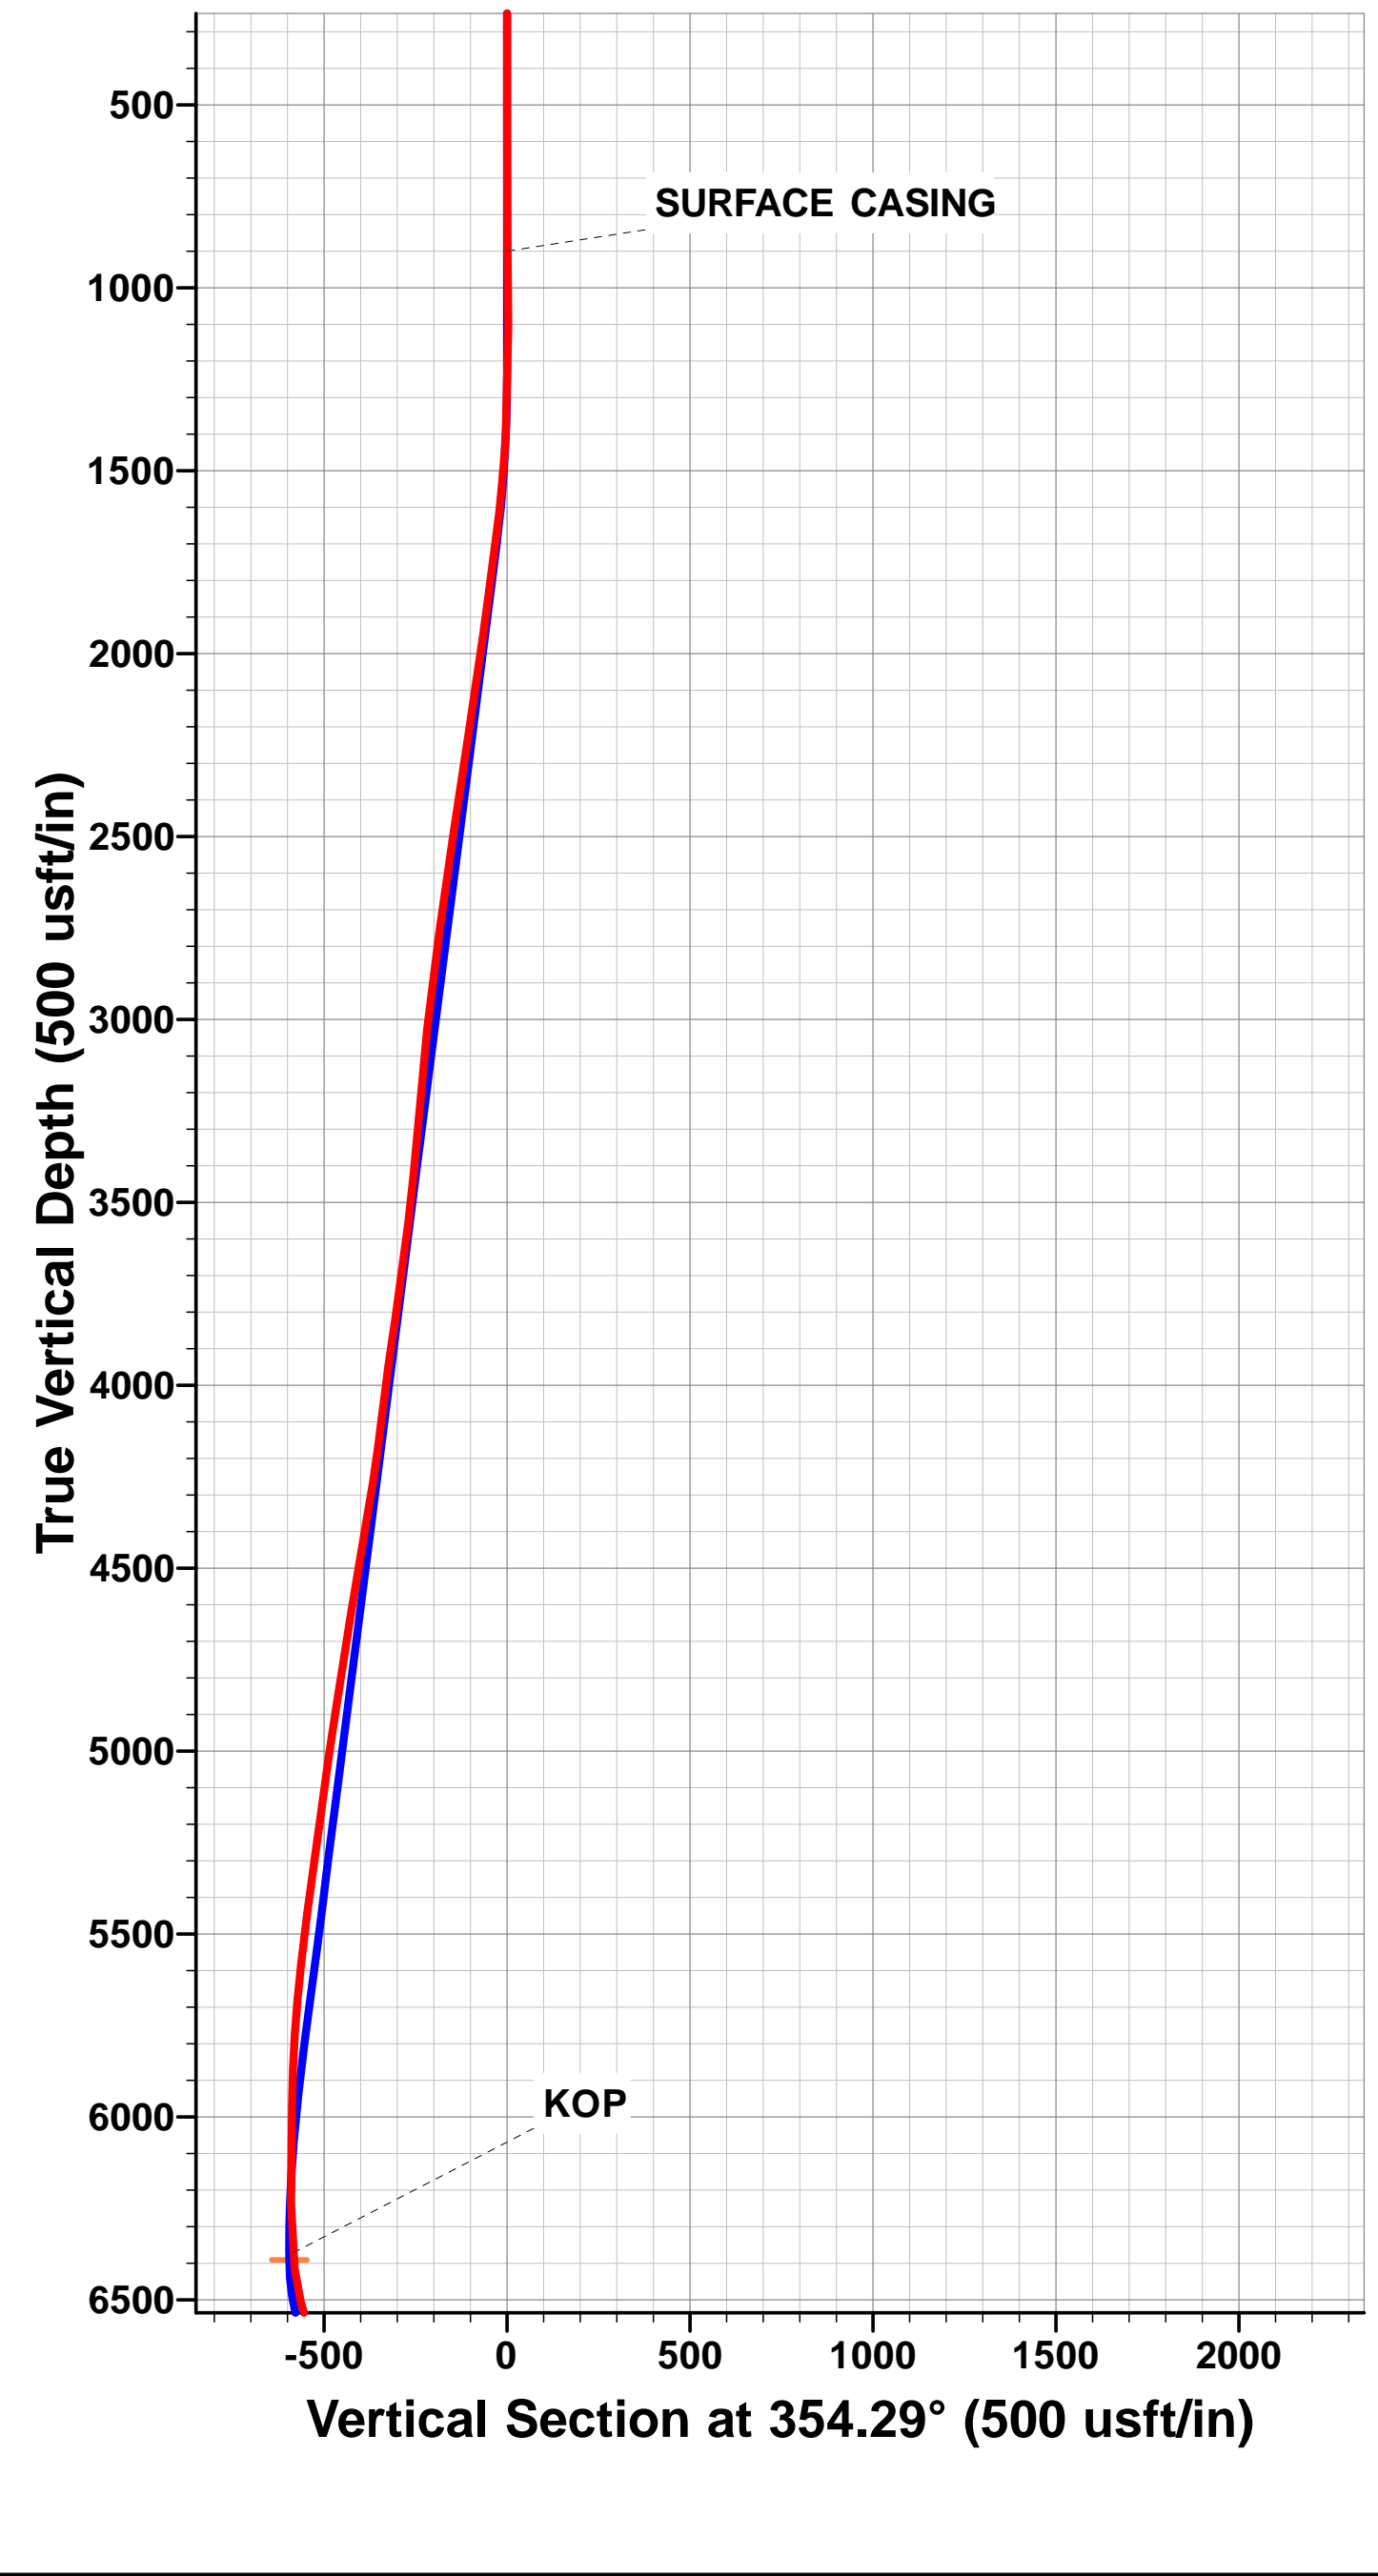

## Survey Report



|                  |                                 |                                     |                           |
|------------------|---------------------------------|-------------------------------------|---------------------------|
| <b>Company:</b>  | PDC ENERGY                      | <b>Local Co-ordinate Reference:</b> | Well RIEDER 18T-221       |
| <b>Project:</b>  | WELD COUNTY, COLORADO           | <b>TVD Reference:</b>               | KB @ 4819.0usft (ENS 135) |
| <b>Site:</b>     | SE SE SEC. 18 T4N R67W 6th P.M. | <b>MD Reference:</b>                | KB @ 4819.0usft (ENS 135) |
| <b>Well:</b>     | RIEDER 18T-221                  | <b>North Reference:</b>             | True                      |
| <b>Wellbore:</b> | JOB # 2015-044-135              | <b>Survey Calculation Method:</b>   | Minimum Curvature         |
| <b>Design:</b>   | FINAL SURVEYS                   | <b>Database:</b>                    | EDM 5000.1 Single User Db |

|                    |                           |                      |                             |
|--------------------|---------------------------|----------------------|-----------------------------|
| <b>Project</b>     | WELD COUNTY, COLORADO     |                      |                             |
| <b>Map System:</b> | US State Plane 1983       | <b>System Datum:</b> | Mean Sea Level              |
| <b>Geo Datum:</b>  | North American Datum 1983 |                      |                             |
| <b>Map Zone:</b>   | Colorado Northern Zone    |                      | Using geodetic scale factor |

|                       |                                 |              |                   |                   |             |
|-----------------------|---------------------------------|--------------|-------------------|-------------------|-------------|
| Site                  | SE SE SEC. 18 T4N R67W 6th P.M. |              |                   |                   |             |
| Site Position:        |                                 | Northing:    | 1,355,509.25 usft | Latitude:         | 40.307850   |
| From:                 | Lat/Long                        | Easting:     | 3,160,139.69 usft | Longitude:        | -104.925790 |
| Position Uncertainty: | 0.0 usft                        | Slot Radius: | 1.10000 ft        | Grid Convergence: | 0.37 °      |

|                      |                |          |                     |                   |               |              |
|----------------------|----------------|----------|---------------------|-------------------|---------------|--------------|
| Well                 | RIEDER 18T-221 |          |                     |                   |               |              |
| Well Position        | +N-S           | 0.0 usft | Northing:           | 1,355,509.63 usft | Latitude:     | 40.307850    |
|                      | +E-W           | 0.0 usft | Easting:            | 3,160,201.05 usft | Longitude:    | -104.925570  |
| Position Uncertainty |                | 0.0 usft | Wellhead Elevation: | usft              | Ground Level: | 4,806.0 usft |

|                  |                    |                    |                        |                      |                            |
|------------------|--------------------|--------------------|------------------------|----------------------|----------------------------|
| <b>Wellbore</b>  | JOB # 2015-044-135 |                    |                        |                      |                            |
| <b>Magnetics</b> | <b>Model Name</b>  | <b>Sample Date</b> | <b>Declination (°)</b> | <b>Dip Angle (°)</b> | <b>Field Strength (nT)</b> |
|                  | IGRF2015           | 28/04/2015         | 8.51                   | 66.81                | 52,571                     |

|                          |                                |                    |                    |                      |     |
|--------------------------|--------------------------------|--------------------|--------------------|----------------------|-----|
| <b>Design</b>            | FINAL SURVEYS                  |                    |                    |                      |     |
| <b>Audit Notes:</b>      |                                |                    |                    |                      |     |
| <b>Version:</b>          | 1.0                            | <b>Phase:</b>      | ACTUAL             | <b>Tie On Depth:</b> | 0.0 |
| <b>Vertical Section:</b> | <b>Depth From (TVD) (usft)</b> | <b>+N-S (usft)</b> | <b>+E-W (usft)</b> | <b>Direction (°)</b> |     |
|                          | 0.0                            | 0.0                | 0.0                | 354.29               |     |

|                       |                  |                                    |                  |                    |  |
|-----------------------|------------------|------------------------------------|------------------|--------------------|--|
| <b>Survey Program</b> | <b>Date</b>      | 20/06/2015                         |                  |                    |  |
| <b>From (usft)</b>    | <b>To (usft)</b> | <b>Survey (Wellbore)</b>           | <b>Tool Name</b> | <b>Description</b> |  |
| 0.0                   | 11,543.0         | FINAL SURVEYS (JOB # 2015-044-135) | MWD              | MWD - Standard     |  |

| <b>Survey</b>         |                 |             |                       |                     |             |             |                         |                         |                        |                       |
|-----------------------|-----------------|-------------|-----------------------|---------------------|-------------|-------------|-------------------------|-------------------------|------------------------|-----------------------|
| Measured Depth (usft) | Inclination (°) | Azimuth (°) | Vertical Depth (usft) | Subsea Depth (usft) | +N-S (usft) | +E-W (usft) | Vertical Section (usft) | Dogleg Rate (°/100usft) | Build Rate (°/100usft) | Turn Rate (°/100usft) |
| 0.0                   | 0.00            | 0.00        | 0.0                   | 4,819.0             | 0.0         | 0.0         | 0.0                     | 0.00                    | 0.00                   | 0.00                  |
| 265.0                 | 0.10            | 68.50       | 265.0                 | 4,554.0             | 0.1         | 0.2         | 0.1                     | 0.04                    | 0.04                   | 0.00                  |
| 546.0                 | 0.50            | 262.20      | 546.0                 | 4,273.0             | 0.0         | -0.8        | 0.1                     | 0.21                    | 0.14                   | -59.18                |
| 827.0                 | 1.20            | 280.70      | 827.0                 | 3,992.0             | 0.4         | -4.9        | 0.9                     | 0.26                    | 0.25                   | 6.58                  |
| <b>SURFACE CASING</b> |                 |             |                       |                     |             |             |                         |                         |                        |                       |
| 900.0                 | 1.20            | 283.49      | 899.9                 | 3,919.1             | 0.7         | -6.4        | 1.3                     | 0.08                    | -0.01                  | 3.83                  |
| 1,106.0               | 1.20            | 291.40      | 1,105.9               | 3,713.1             | 2.0         | -10.5       | 3.0                     | 0.08                    | 0.00                   | 3.84                  |
| 1,390.0               | 5.00            | 227.40      | 1,389.5               | 3,429.5             | -5.3        | -22.4       | -3.0                    | 1.62                    | 1.34                   | -22.54                |
| 1,671.0               | 8.00            | 199.30      | 1,668.7               | 3,150.3             | -32.1       | -37.8       | -28.1                   | 1.53                    | 1.07                   | -10.00                |
| 1,952.0               | 9.50            | 209.10      | 1,946.5               | 2,872.5             | -70.8       | -55.6       | -64.9                   | 0.75                    | 0.53                   | 3.49                  |
| 2,230.0               | 9.80            | 199.60      | 2,220.5               | 2,598.5             | -113.1      | -74.7       | -105.1                  | 0.58                    | 0.11                   | -3.42                 |
| 2,501.0               | 9.70            | 205.20      | 2,487.6               | 2,331.4             | -155.5      | -92.1       | -145.6                  | 0.35                    | -0.04                  | 2.07                  |
| 2,772.0               | 10.10           | 209.80      | 2,754.6               | 2,064.4             | -196.8      | -113.7      | -184.5                  | 0.33                    | 0.15                   | 1.70                  |

## Survey Report



|                  |                                 |                                     |                           |
|------------------|---------------------------------|-------------------------------------|---------------------------|
| <b>Company:</b>  | PDC ENERGY                      | <b>Local Co-ordinate Reference:</b> | Well RIEDER 18T-221       |
| <b>Project:</b>  | WELD COUNTY, COLORADO           | <b>TVD Reference:</b>               | KB @ 4819.0usft (ENS 135) |
| <b>Site:</b>     | SE SE SEC. 18 T4N R67W 6th P.M. | <b>MD Reference:</b>                | KB @ 4819.0usft (ENS 135) |
| <b>Well:</b>     | RIEDER 18T-221                  | <b>North Reference:</b>             | True                      |
| <b>Wellbore:</b> | JOB # 2015-044-135              | <b>Survey Calculation Method:</b>   | Minimum Curvature         |
| <b>Design:</b>   | FINAL SURVEYS                   | <b>Database:</b>                    | EDM 5000.1 Single User Db |

## Survey

| Measured Depth (usft) | Inclination (°) | Azimuth (°) | Vertical Depth (usft) | Subsea Depth (usft) | +N/-S (usft) | +E/-W (usft) | Vertical Section (usft) | Dogleg Rate (°/100usft) | Build Rate (°/100usft) | Turn Rate (°/100usft) |
|-----------------------|-----------------|-------------|-----------------------|---------------------|--------------|--------------|-------------------------|-------------------------|------------------------|-----------------------|
| 3,044.0               | 9.20            | 225.30      | 3,022.8               | 1,796.2             | -232.8       | -141.0       | -217.6                  | 1.01                    | -0.33                  | 5.70                  |
| 3,315.0               | 9.60            | 233.30      | 3,290.2               | 1,528.8             | -261.5       | -174.5       | -242.9                  | 0.50                    | 0.15                   | 2.95                  |
| 3,586.0               | 11.30           | 228.60      | 3,556.7               | 1,262.3             | -292.6       | -212.5       | -270.0                  | 0.70                    | 0.63                   | -1.73                 |
| 3,857.0               | 11.80           | 217.30      | 3,822.2               | 996.8               | -332.2       | -249.2       | -305.7                  | 0.85                    | 0.18                   | -4.17                 |
| 4,128.0               | 8.70            | 211.90      | 4,088.9               | 730.1               | -371.6       | -276.9       | -342.3                  | 1.20                    | -1.14                  | -1.99                 |
| 4,399.0               | 11.30           | 203.90      | 4,355.7               | 463.3               | -413.3       | -298.5       | -381.6                  | 1.09                    | 0.96                   | -2.95                 |
| 4,671.0               | 10.40           | 203.10      | 4,622.9               | 196.1               | -460.3       | -318.9       | -426.3                  | 0.34                    | -0.33                  | -0.29                 |
| 4,942.0               | 10.10           | 204.10      | 4,889.5               | -70.5               | -504.5       | -338.2       | -468.3                  | 0.13                    | -0.11                  | 0.37                  |
| 5,213.0               | 8.60            | 203.40      | 5,156.9               | -337.9              | -544.8       | -355.9       | -506.6                  | 0.56                    | -0.55                  | -0.26                 |
| 5,485.0               | 10.00           | 211.10      | 5,425.4               | -606.4              | -583.6       | -376.2       | -543.3                  | 0.69                    | 0.51                   | 2.83                  |
| 5,756.0               | 6.50            | 216.70      | 5,693.5               | -874.5              | -616.1       | -397.6       | -573.5                  | 1.32                    | -1.29                  | 2.07                  |
| 6,027.0               | 1.10            | 203.80      | 5,963.8               | -1,144.8            | -630.8       | -407.8       | -587.1                  | 2.00                    | -1.99                  | -4.76                 |
| 6,298.0               | 0.50            | 147.30      | 6,234.8               | -1,415.8            | -634.2       | -408.2       | -590.4                  | 0.34                    | -0.22                  | -20.85                |
| <b>KOP</b>            |                 |             |                       |                     |              |              |                         |                         |                        |                       |
| 6,435.0               | 5.12            | 356.96      | 6,371.6               | -1,552.6            | -628.6       | -408.2       | -584.8                  | 4.06                    | 3.37                   | -109.74               |
| 6,479.0               | 6.90            | 356.30      | 6,415.4               | -1,596.4            | -624.0       | -408.5       | -580.2                  | 4.06                    | 4.05                   | -1.51                 |
| 6,569.0               | 13.70           | 359.90      | 6,503.9               | -1,684.9            | -607.9       | -408.8       | -564.2                  | 7.59                    | 7.56                   | 4.00                  |
| 6,659.0               | 19.30           | 0.80        | 6,590.1               | -1,771.1            | -582.3       | -408.6       | -538.8                  | 6.23                    | 6.22                   | 1.00                  |
| 6,750.0               | 27.90           | 357.00      | 6,673.5               | -1,854.5            | -546.0       | -409.5       | -502.5                  | 9.59                    | 9.45                   | -4.18                 |
| 6,840.0               | 38.90           | 357.60      | 6,748.5               | -1,929.5            | -496.6       | -411.8       | -453.1                  | 12.23                   | 12.22                  | 0.67                  |
| 6,930.0               | 44.80           | 354.70      | 6,815.5               | -1,996.5            | -436.7       | -416.0       | -393.1                  | 6.90                    | 6.56                   | -3.22                 |
| 7,020.0               | 51.00           | 358.60      | 6,875.8               | -2,056.8            | -370.1       | -419.7       | -326.5                  | 7.60                    | 6.89                   | 4.33                  |
| 7,111.0               | 62.10           | 359.60      | 6,925.9               | -2,106.9            | -294.3       | -420.9       | -250.9                  | 12.23                   | 12.20                  | 1.10                  |
| 7,201.0               | 74.20           | 359.20      | 6,959.3               | -2,140.3            | -210.9       | -421.8       | -167.9                  | 13.45                   | 13.44                  | -0.44                 |
| 7,275.0               | 81.60           | 359.50      | 6,974.8               | -2,155.8            | -138.6       | -422.6       | -95.9                   | 10.01                   | 10.00                  | 0.41                  |
| <b>ICP</b>            |                 |             |                       |                     |              |              |                         |                         |                        |                       |
| 7,339.0               | 87.47           | 357.83      | 6,980.9               | -2,161.9            | -74.9        | -424.1       | -32.4                   | 9.54                    | 9.18                   | -2.61                 |
| 7,348.0               | 88.30           | 357.60      | 6,981.3               | -2,162.3            | -66.0        | -424.4       | -23.4                   | 9.54                    | 9.18                   | -2.58                 |
| 7,407.0               | 90.40           | 358.10      | 6,981.9               | -2,162.9            | -7.0         | -426.7       | 35.5                    | 3.66                    | 3.56                   | 0.85                  |
| 7,497.0               | 91.60           | 359.50      | 6,980.4               | -2,161.4            | 83.0         | -428.5       | 125.2                   | 2.05                    | 1.33                   | 1.56                  |
| 7,588.0               | 91.20           | 359.20      | 6,978.1               | -2,159.1            | 173.9        | -429.6       | 215.8                   | 0.55                    | -0.44                  | -0.33                 |
| 7,678.0               | 92.30           | 359.90      | 6,975.4               | -2,156.4            | 263.9        | -430.3       | 305.4                   | 1.45                    | 1.22                   | 0.78                  |
| 7,769.0               | 93.10           | 1.60        | 6,971.1               | -2,152.1            | 354.8        | -429.1       | 395.7                   | 2.06                    | 0.88                   | 1.87                  |
| 7,859.0               | 92.80           | 0.60        | 6,966.5               | -2,147.5            | 444.6        | -427.4       | 484.9                   | 1.16                    | -0.33                  | -1.11                 |
| 7,949.0               | 92.50           | 0.10        | 6,962.3               | -2,143.3            | 534.5        | -426.8       | 574.3                   | 0.65                    | -0.33                  | -0.56                 |
| 8,039.0               | 93.70           | 1.30        | 6,957.4               | -2,138.4            | 624.4        | -425.7       | 663.6                   | 1.88                    | 1.33                   | 1.33                  |
| 8,130.0               | 93.20           | 1.00        | 6,952.0               | -2,133.0            | 715.2        | -423.9       | 753.8                   | 0.64                    | -0.55                  | -0.33                 |
| 8,220.0               | 93.80           | 0.90        | 6,946.5               | -2,127.5            | 805.0        | -422.4       | 843.1                   | 0.68                    | 0.67                   | -0.11                 |
| 8,310.0               | 93.40           | 0.80        | 6,940.8               | -2,121.8            | 894.8        | -421.1       | 932.3                   | 0.46                    | -0.44                  | -0.11                 |
| 8,401.0               | 91.00           | 0.30        | 6,937.3               | -2,118.3            | 985.8        | -420.2       | 1,022.7                 | 2.69                    | -2.64                  | -0.55                 |
| 8,491.0               | 91.60           | 359.70      | 6,935.3               | -2,116.3            | 1,075.7      | -420.2       | 1,112.2                 | 0.94                    | 0.67                   | -0.67                 |
| 8,581.0               | 89.90           | 359.50      | 6,934.1               | -2,115.1            | 1,165.7      | -420.8       | 1,201.8                 | 1.90                    | -1.89                  | -0.22                 |
| 8,671.0               | 90.60           | 359.30      | 6,933.7               | -2,114.7            | 1,255.7      | -421.8       | 1,291.4                 | 0.81                    | 0.78                   | -0.22                 |
| 8,762.0               | 91.30           | 358.70      | 6,932.2               | -2,113.2            | 1,346.7      | -423.4       | 1,382.1                 | 1.01                    | 0.77                   | -0.66                 |
| 8,853.0               | 88.70           | 358.70      | 6,932.2               | -2,113.2            | 1,437.7      | -425.4       | 1,472.8                 | 2.86                    | -2.86                  | 0.00                  |
| 8,943.0               | 89.00           | 359.80      | 6,934.0               | -2,115.0            | 1,527.6      | -426.6       | 1,562.5                 | 1.27                    | 0.33                   | 1.22                  |
| 9,033.0               | 89.40           | 0.20        | 6,935.3               | -2,116.3            | 1,617.6      | -426.6       | 1,652.0                 | 0.63                    | 0.44                   | 0.44                  |
| 9,124.0               | 90.50           | 0.70        | 6,935.3               | -2,116.3            | 1,708.6      | -425.9       | 1,742.5                 | 1.33                    | 1.21                   | 0.55                  |
| 9,214.0               | 90.40           | 359.90      | 6,934.6               | -2,115.6            | 1,798.6      | -425.4       | 1,832.0                 | 0.90                    | -0.11                  | -0.89                 |
| 9,305.0               | 90.50           | 359.60      | 6,933.9               | -2,114.9            | 1,889.6      | -425.8       | 1,922.6                 | 0.35                    | 0.11                   | -0.33                 |
| 9,395.0               | 89.80           | 359.70      | 6,933.7               | -2,114.7            | 1,979.6      | -426.4       | 2,012.2                 | 0.79                    | -0.78                  | 0.11                  |
| 9,486.0               | 89.40           | 0.10        | 6,934.3               | -2,115.3            | 2,070.6      | -426.5       | 2,102.8                 | 0.62                    | -0.44                  | 0.44                  |
| 9,577.0               | 90.30           | 0.10        | 6,934.6               | -2,115.6            | 2,161.6      | -426.4       | 2,193.3                 | 0.99                    | 0.99                   | 0.00                  |

# Survey Report



|                  |                                 |                                     |                           |
|------------------|---------------------------------|-------------------------------------|---------------------------|
| <b>Company:</b>  | PDC ENERGY                      | <b>Local Co-ordinate Reference:</b> | Well RIEDER 18T-221       |
| <b>Project:</b>  | WELD COUNTY, COLORADO           | <b>TVD Reference:</b>               | KB @ 4819.0usft (ENS 135) |
| <b>Site:</b>     | SE SE SEC. 18 T4N R67W 6th P.M. | <b>MD Reference:</b>                | KB @ 4819.0usft (ENS 135) |
| <b>Well:</b>     | RIEDER 18T-221                  | <b>North Reference:</b>             | True                      |
| <b>Wellbore:</b> | JOB # 2015-044-135              | <b>Survey Calculation Method:</b>   | Minimum Curvature         |
| <b>Design:</b>   | FINAL SURVEYS                   | <b>Database:</b>                    | EDM 5000.1 Single User Db |

| Survey                             |                 |             |                       |                     |              |              |                         |                         |                        |                       |
|------------------------------------|-----------------|-------------|-----------------------|---------------------|--------------|--------------|-------------------------|-------------------------|------------------------|-----------------------|
| Measured Depth (usft)              | Inclination (°) | Azimuth (°) | Vertical Depth (usft) | Subsea Depth (usft) | +N/-S (usft) | +E/-W (usft) | Vertical Section (usft) | Dogleg Rate (°/100usft) | Build Rate (°/100usft) | Turn Rate (°/100usft) |
| 9,667.0                            | 89.00           | 0.30        | 6,935.1               | -2,116.1            | 2,251.6      | -426.0       | 2,282.8                 | 1.46                    | -1.44                  | 0.22                  |
| 9,757.0                            | 90.00           | 0.30        | 6,935.9               | -2,116.9            | 2,341.6      | -425.6       | 2,372.3                 | 1.11                    | 1.11                   | 0.00                  |
| 9,848.0                            | 89.80           | 359.50      | 6,936.1               | -2,117.1            | 2,432.6      | -425.7       | 2,462.9                 | 0.91                    | -0.22                  | -0.88                 |
| 9,938.0                            | 89.40           | 357.20      | 6,936.7               | -2,117.7            | 2,522.5      | -428.3       | 2,552.6                 | 2.59                    | -0.44                  | -2.56                 |
| 10,028.0                           | 90.20           | 359.30      | 6,937.0               | -2,118.0            | 2,612.5      | -431.1       | 2,642.4                 | 2.50                    | 0.89                   | 2.33                  |
| 10,119.0                           | 90.80           | 359.70      | 6,936.2               | -2,117.2            | 2,703.5      | -431.9       | 2,733.0                 | 0.79                    | 0.66                   | 0.44                  |
| 10,210.0                           | 90.40           | 1.50        | 6,935.3               | -2,116.3            | 2,794.5      | -430.9       | 2,823.5                 | 2.03                    | -0.44                  | 1.98                  |
| 10,300.0                           | 90.00           | 1.20        | 6,934.9               | -2,115.9            | 2,884.4      | -428.8       | 2,912.8                 | 0.56                    | -0.44                  | -0.33                 |
| 10,390.0                           | 91.00           | 0.10        | 6,934.2               | -2,115.2            | 2,974.4      | -427.8       | 3,002.2                 | 1.65                    | 1.11                   | -1.22                 |
| 10,481.0                           | 90.60           | 1.10        | 6,932.9               | -2,113.9            | 3,065.4      | -426.8       | 3,092.7                 | 1.18                    | -0.44                  | 1.10                  |
| 10,571.0                           | 90.10           | 0.40        | 6,932.3               | -2,113.3            | 3,155.4      | -425.6       | 3,182.1                 | 0.96                    | -0.56                  | -0.78                 |
| 10,662.0                           | 91.40           | 358.80      | 6,931.1               | -2,112.1            | 3,246.4      | -426.3       | 3,272.7                 | 2.27                    | 1.43                   | -1.76                 |
| 10,752.0                           | 88.00           | 0.30        | 6,931.6               | -2,112.6            | 3,336.4      | -427.0       | 3,362.3                 | 4.13                    | -3.78                  | 1.67                  |
| 10,842.0                           | 87.00           | 359.70      | 6,935.5               | -2,116.5            | 3,426.3      | -427.0       | 3,451.8                 | 1.30                    | -1.11                  | -0.67                 |
| 10,933.0                           | 88.30           | 359.80      | 6,939.3               | -2,120.3            | 3,517.2      | -427.4       | 3,542.3                 | 1.43                    | 1.43                   | 0.11                  |
| 11,023.0                           | 89.20           | 1.60        | 6,941.2               | -2,122.2            | 3,607.2      | -426.3       | 3,631.7                 | 2.24                    | 1.00                   | 2.00                  |
| 11,113.0                           | 88.80           | 1.00        | 6,942.8               | -2,123.8            | 3,697.1      | -424.2       | 3,721.0                 | 0.80                    | -0.44                  | -0.67                 |
| 11,204.0                           | 90.60           | 2.00        | 6,943.3               | -2,124.3            | 3,788.1      | -421.9       | 3,811.3                 | 2.26                    | 1.98                   | 1.10                  |
| 11,294.0                           | 91.20           | 2.00        | 6,941.9               | -2,122.9            | 3,878.0      | -418.7       | 3,900.4                 | 0.67                    | 0.67                   | 0.00                  |
| 11,385.0                           | 91.70           | 2.20        | 6,939.6               | -2,120.6            | 3,968.9      | -415.4       | 3,990.6                 | 0.59                    | 0.55                   | 0.22                  |
| 11,475.0                           | 91.40           | 1.90        | 6,937.1               | -2,118.1            | 4,058.8      | -412.2       | 4,079.7                 | 0.47                    | -0.33                  | -0.33                 |
| <b>LAST SURVEY - JUNE 19, 2014</b> |                 |             |                       |                     |              |              |                         |                         |                        |                       |
| 11,491.0                           | 91.30           | 2.10        | 6,936.8               | -2,117.8            | 4,074.8      | -411.6       | 4,095.6                 | 1.40                    | -0.62                  | 1.25                  |
| <b>EXTRAPOLATION TO TD</b>         |                 |             |                       |                     |              |              |                         |                         |                        |                       |
| 11,543.0                           | 91.30           | 2.10        | 6,935.6               | -2,116.6            | 4,126.8      | -409.7       | 4,147.1                 | 0.00                    | 0.00                   | 0.00                  |

## Survey Report



|                  |                                 |                                     |                           |
|------------------|---------------------------------|-------------------------------------|---------------------------|
| <b>Company:</b>  | PDC ENERGY                      | <b>Local Co-ordinate Reference:</b> | Well RIEDER 18T-221       |
| <b>Project:</b>  | WELD COUNTY, COLORADO           | <b>TVD Reference:</b>               | KB @ 4819.0usft (ENS 135) |
| <b>Site:</b>     | SE SE SEC. 18 T4N R67W 6th P.M. | <b>MD Reference:</b>                | KB @ 4819.0usft (ENS 135) |
| <b>Well:</b>     | RIEDER 18T-221                  | <b>North Reference:</b>             | True                      |
| <b>Wellbore:</b> | JOB # 2015-044-135              | <b>Survey Calculation Method:</b>   | Minimum Curvature         |
| <b>Design:</b>   | FINAL SURVEYS                   | <b>Database:</b>                    | EDM 5000.1 Single User Db |

| Targets                |  |           |          |         |         |          |              |              |                       |
|------------------------|--|-----------|----------|---------|---------|----------|--------------|--------------|-----------------------|
| Target Name            | - hit/miss target  | Dip Angle | Dip Dir. | TVD     | +N/-S   | +E/-W    | Northing     | Easting      |                       |
| - Shape                |  | (°)       | (°)      | (usft)  | (usft)  | (usft)   | (usft)       | (usft)       | Latitude Longitude    |
| KOP - RIEDER 18T-2     | - survey misses target center by 13.1usft at 6453.6usft MD (6390.1 TVD, -626.8 N, -408.3 E)    | 0.00      | 0.00     | 6,391.4 | -639.1  | -412.7   | 1,354,867.90 | 3,159,792.51 | 40.306096 -104.927050 |
| - Point                |  |           |          |         |         |          |              |              |                       |
| 7" ICP *NEW* - RIEDI   | - survey misses target center by 39.2usft at 7297.2usft MD (6977.7 TVD, -116.6 N, -422.9 E)    | 0.00      | 0.00     | 6,940.0 | -112.8  | -412.7   | 1,355,394.17 | 3,159,789.10 | 40.307540 -104.927050 |
| - Point                |  |           |          |         |         |          |              |              |                       |
| EXIST VERT EVERY-      | - survey misses target center by 451.5usft at 8567.8usft MD (6934.1 TVD, 1152.5 N, -420.7 E)   | 0.00      | 0.00     | 7,192.0 | 1,158.5 | -50.2    | 1,356,667.73 | 3,160,143.35 | 40.311030 -104.925750 |
| - Circle (radius 30.0) |  |           |          |         |         |          |              |              |                       |
| EXIST VERT STARCI      | - survey misses target center by 2272.5usft at 8894.2usft MD (6933.1 TVD, 1478.8 N, -426.2 E)  | 0.00      | 0.00     | 7,791.0 | 1,434.0 | -2,530.0 | 1,356,927.19 | 3,157,661.88 | 40.311786 -104.934642 |
| - Circle (radius 30.0) |  |           |          |         |         |          |              |              |                       |
| EXIST VERT BEIN 6-     | - survey misses target center by 2254.1usft at 10136.7usft MD (6936.0 TVD, 2721.2 N, -431.9 E) | 0.00      | 0.00     | 7,756.0 | 2,751.7 | -2,531.3 | 1,358,244.80 | 3,157,652.08 | 40.315403 -104.934647 |
| - Circle (radius 30.0) |  |           |          |         |         |          |              |              |                       |
| BHL - RIEDER 18T-2:    | - survey misses target center by 7.1usft at 11543.0usft MD (6935.6 TVD, 4126.8 N, -409.7 E)    | 0.00      | 0.00     | 6,942.0 | 4,127.6 | -412.7   | 1,359,634.30 | 3,159,761.63 | 40.319180 -104.927050 |
| - Point                |  |           |          |         |         |          |              |              |                       |
| BHL - RIEDER 18T-2:    | - survey misses target center by 3.1usft at 11543.0usft MD (6935.6 TVD, 4126.8 N, -409.7 E)    | 0.00      | 0.00     | 6,936.0 | 4,127.6 | -412.7   | 1,359,634.30 | 3,159,761.63 | 40.319180 -104.927050 |
| - Point                |  |           |          |         |         |          |              |              |                       |
| 7" ICP *NEW* - RIEDI   | - survey misses target center by 31.8usft at 7299.6usft MD (6978.0 TVD, -114.2 N, -422.9 E)    | 0.00      | 0.00     | 6,948.0 | -111.1  | -412.7   | 1,355,395.87 | 3,159,789.09 | 40.307545 -104.927050 |
| - Point                |  |           |          |         |         |          |              |              |                       |
| EXIST VERT BEIN 3-     | - survey misses target center by 2037.7usft at 11543.0usft MD (6935.6 TVD, 4126.8 N, -409.7 E) | 0.00      | 0.00     | 7,264.0 | 4,280.7 | -2,414.9 | 1,359,774.44 | 3,157,758.61 | 40.319600 -104.934230 |
| - Circle (radius 30.0) |  |           |          |         |         |          |              |              |                       |
| KOP - RIEDER 18T-2     | - survey misses target center by 12.4usft at 6445.6usft MD (6382.2 TVD, -627.6 N, -408.2 E)    | 0.00      | 0.00     | 6,383.4 | -639.1  | -412.7   | 1,354,867.90 | 3,159,792.51 | 40.306096 -104.927050 |
| - Point                |  |           |          |         |         |          |              |              |                       |
| EXIST VERT STARCI      | - survey misses target center by 2249.9usft at 7524.3usft MD (6979.6 TVD, 110.3 N, -428.8 E)   | 0.00      | 0.00     | 7,798.0 | 106.5   | -2,524.6 | 1,355,599.78 | 3,157,675.92 | 40.308142 -104.934622 |
| - Circle (radius 30.0) |  |           |          |         |         |          |              |              |                       |

| Survey Annotations    |                       |                   |              |                             |
|-----------------------|-----------------------|-------------------|--------------|-----------------------------|
| Measured Depth (usft) | Vertical Depth (usft) | Local Coordinates |              | Comment                     |
|                       |                       | +N/-S (usft)      | +E/-W (usft) |                             |
| 900.0                 | 899.9                 | 0.7               | -6.4         | SURFACE CASING              |
| 6,435.0               | 6,371.6               | -628.6            | -408.2       | KOP                         |
| 7,339.0               | 6,980.9               | -74.9             | -424.1       | ICP                         |
| 11,491.0              | 6,936.8               | 4,074.8           | -411.6       | LAST SURVEY - JUNE 19, 2014 |
| 11,543.0              | 6,935.6               | 4,126.8           | -409.7       | EXTRAPOLATION TO TD         |

Checked By: \_\_\_\_\_ Approved By: \_\_\_\_\_ Date: \_\_\_\_\_