


Well Name: RASMUSSEN 01

VERTICAL - ORIGINAL HOLE, 9/9/2015 9:42:22 AM

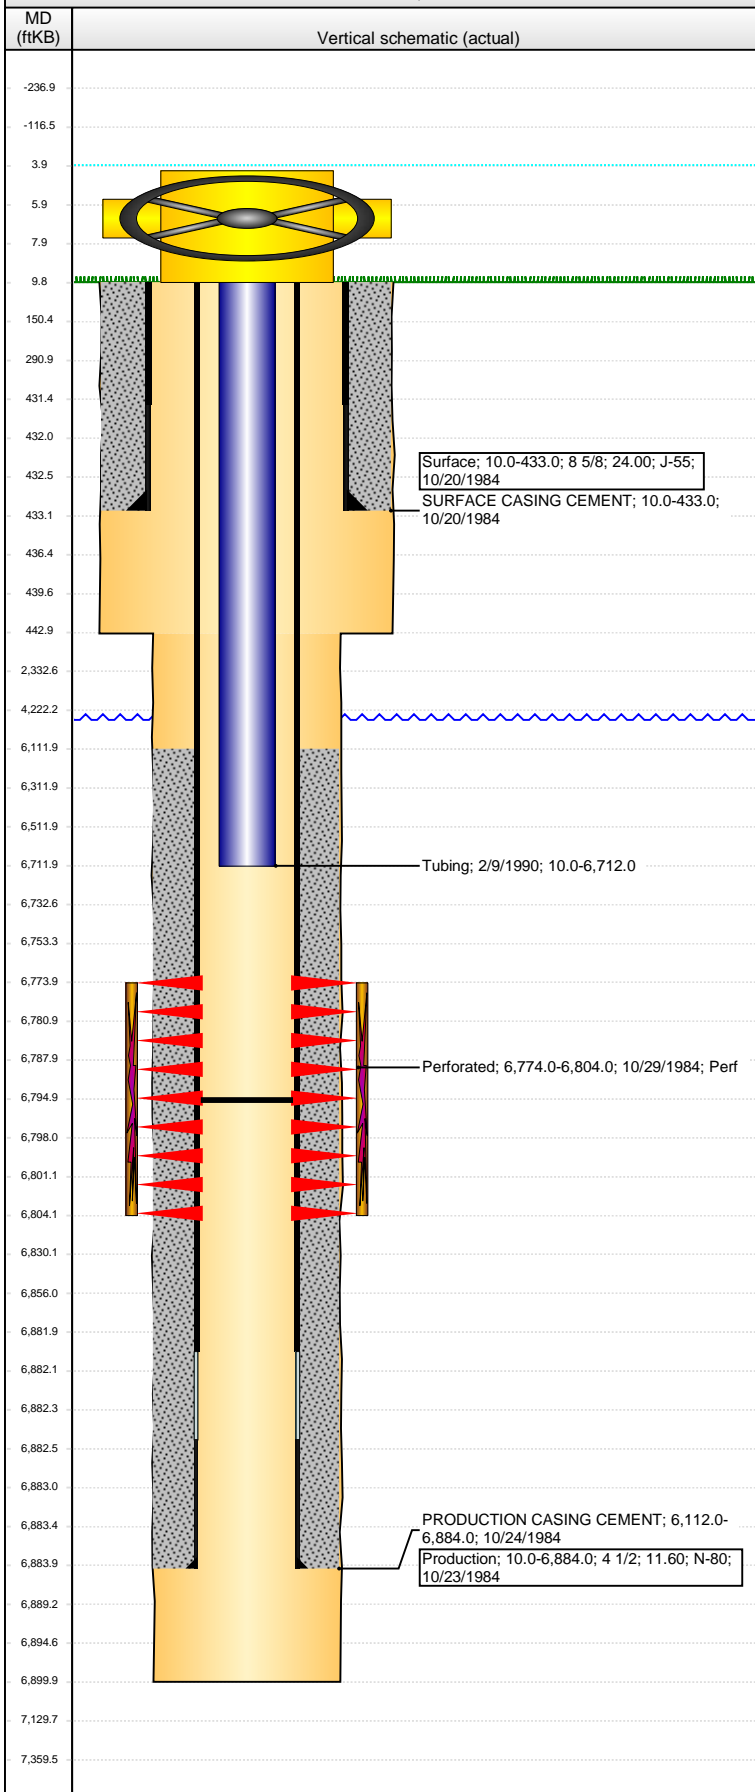

Well Header

API	Business Unit	District	Well Config
05-123-12033	DJ BASIN	15	VERTICAL
Original KB Elevation (ft)	KB - GL / MSL (ftKB)	Spud Date	P & A Date
4,684.00	10.00	10/19/1984	

Comment

DISC: TD 6900' DRL RPT, 6884' ON ST & LOGS

Directions To Well

Congressional Location

Quarter 1	Quarter 2	Quarter 3	Quarter 4	Section	Township	Twnshp N...	Range	Rng E/W Dir
		NW	NE	26	4	N	64	W

Bottom Hole Location

North-South Distance (ft)	From N or S Line	East-West Distance (ft)	From E or W Line

Plug Back Total Depths

Date	Depth (ftKB)	Method	Com
10/29/1984	6,832.0	CASED HOLE LOG	DEPTH LOGGER ON CBL
2/9/1990	6,795.0	TAG	CLEANOUT TO 6795'

Wellbore Sections

Section Des	Size (in)	Act Top, MD (ftKB)	Act Btm, MD (ftKB)
SURFACE	12 1/4	10.0	443.0
PRODUCTION	7 7/8	443.0	6,900.0

Zone Statuses

Zone Name	Status Date	Status	Fluid Type	Job	Prod Method
CODELL	12/7/1984	PR	Oil	DRILLING/CO...	

Casing Strings

Surface, 433.0ftKB

Casing Description	Run Date	OD (in)	Wt/Len (l...	Grade	Top, MD (ft...	MD (ftKB)
Surface	10/20/1984	8 5/8	24.00	J-55	10.0	433.0

Production, 6,884.0ftKB

Casing Description	Run Date	OD (in)	Wt/Len (l...	Grade	Top, MD (ft...	MD (ftKB)
Production	10/23/1984	4 1/2	11.60	N-80	10.0	6,884.0

Cement

Description	Top Depth (ftKB)	Bottom Depth (ftKB)
SURFACE CASING CEMENT	10.0	433.0
PRODUCTION CASING CEMENT	6,112.0	6,884.0

Tubing Strings

Tubing Description	Run Date	String...	ID (in)	Wt (lb/ft)	Grade	Len (ft)	Set De...
Tubing	2/9/1990	2 3/8	1.995	4.70	J-55	6,702.00	

Tubing Components

Item Des	OD (in)	Wt (lb/ft)	Grade	Jts	Len (ft)	Btm (ftKB)	Btm (TVD) (ftKB)
Tubing	2 3/8	4.70	J-55	214	6,702.00	6,712.0	

Perforation Data

Zone	Bnch/St g	Entered Shot Total	Top (ftKB)	Btm (ftKB)	Date
CODELL, ORIGINAL HOLE		20	6,774.00	6,804.00	10/29/1984

Stimulations & Treatments

Date	Zone	Primary Job Type	
10/30/1984	CODELL, ORIGINAL HOLE	DRILLING/COMPLETION - ORIGINAL	
Technical Result		Tech Result Details	Tech Result Note
Comment			

Other In Hole

Run Date	Des	OD (in)	Top (ftKB)	Btm (ftKB)

Logs

Date	Type	Top, MD (ftKB)	Btm, MD (ftKB)
10/23/1984	COMPENSATED NEUTRON	6,100.0	6,884.0
10/23/1984	INDUCTION	400.0	6,884.0
10/29/1984	CEMENT BOND	6,000.0	6,829.0
2/22/2011	GYRO	10.0	6,725.0