


Project: Arapahoe County, Colorado  
Site: Sec. 12-T4S-R64W  
Well: Walker 12-1H

# Conoco Phillips Company

**HALLIBURTON**  
Sperry Drilling

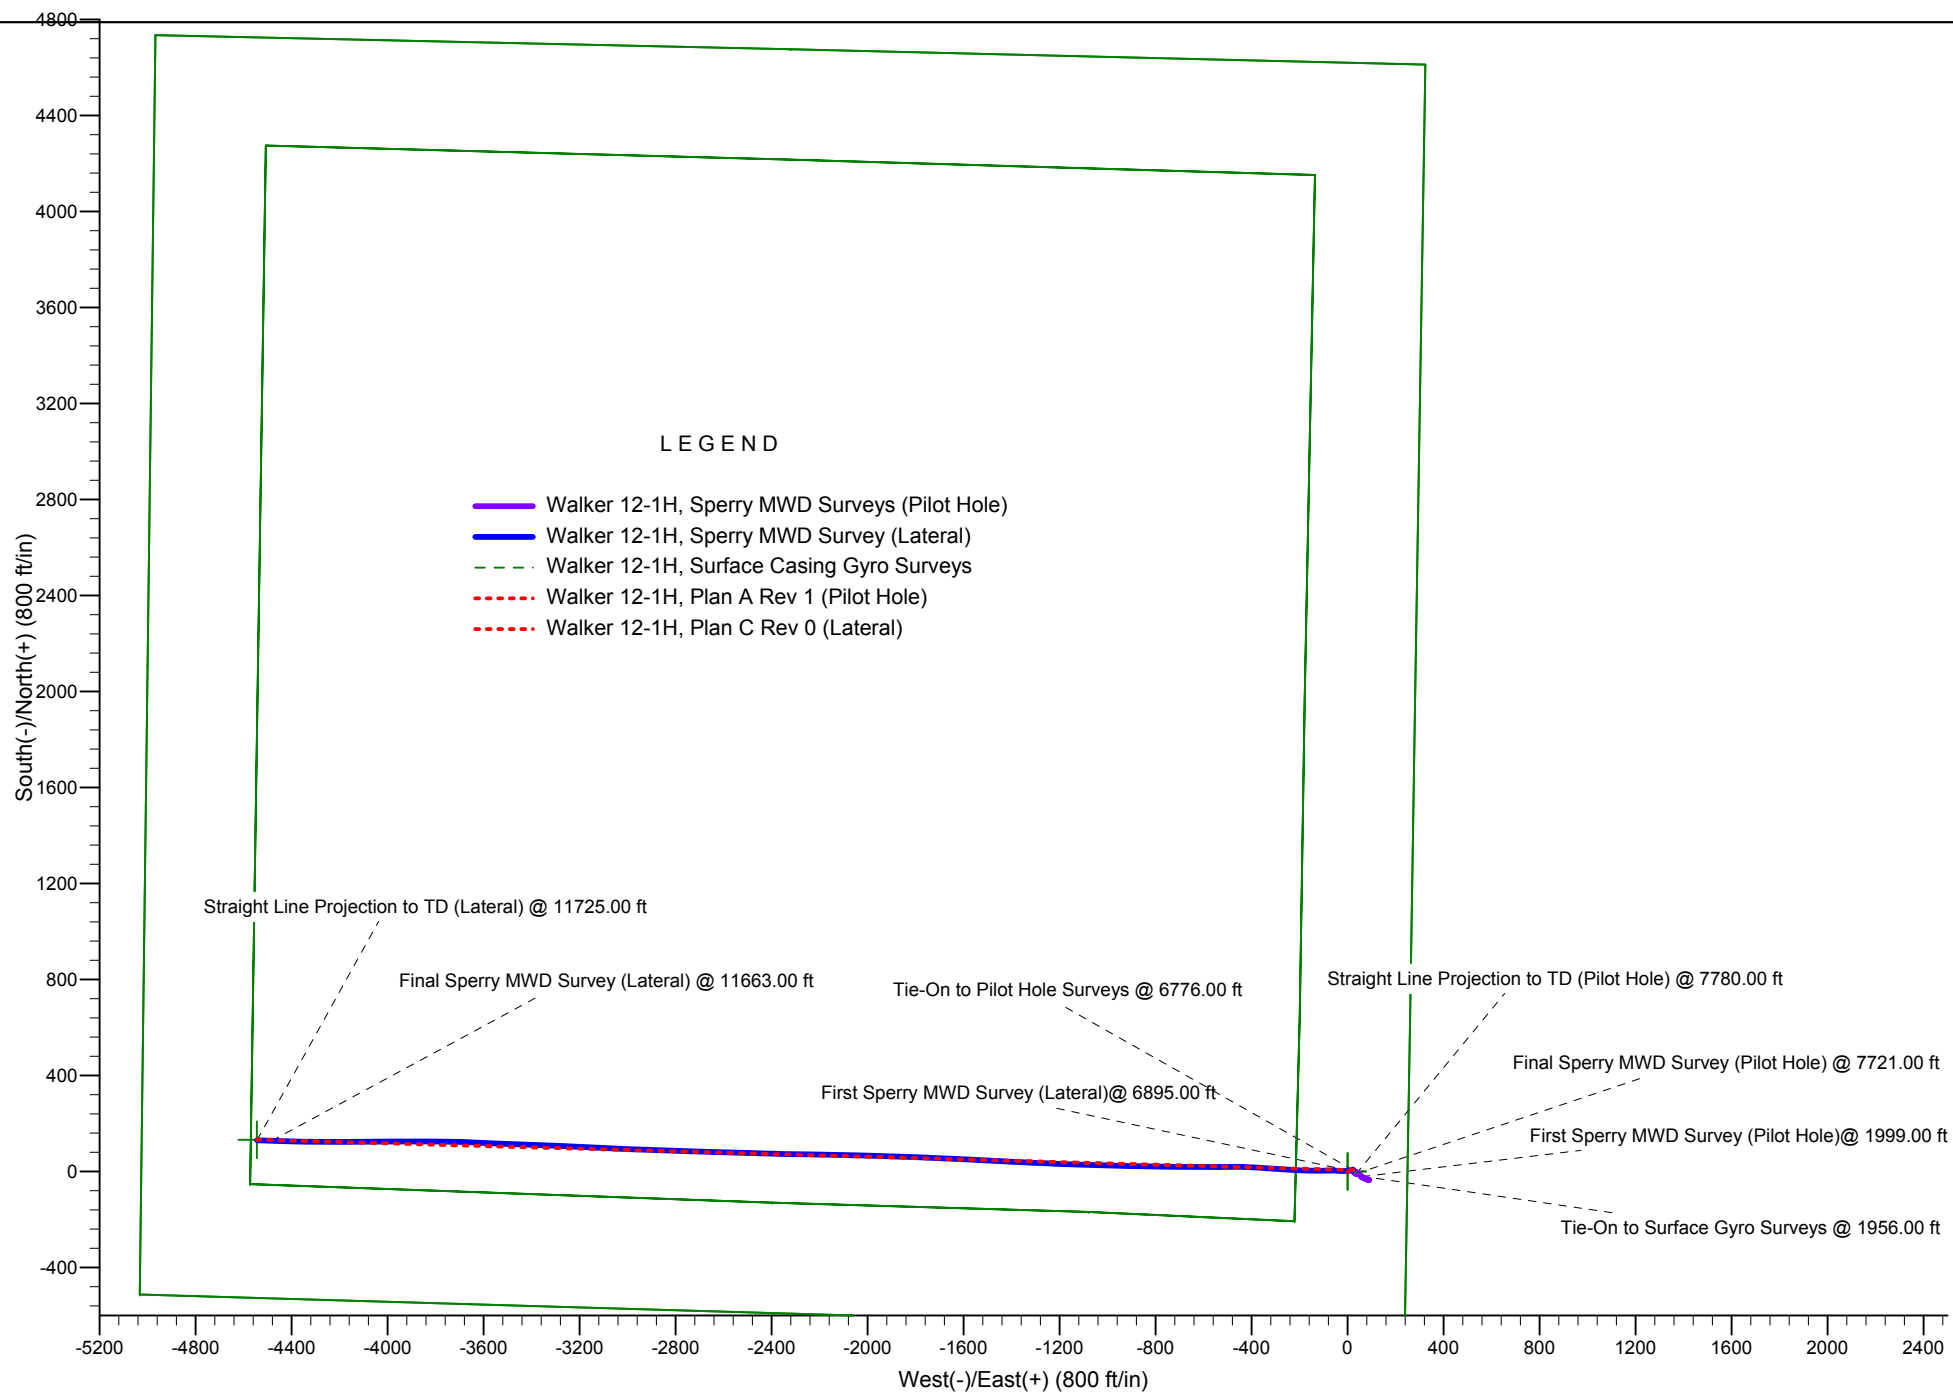

Project: Arapahoe County, Colorado  
Site: Sec. 12-T4S-R64W  
Well: Walker 12-1H

# Conoco Phillips Company

**HALLIBURTON**  
Sperry Drilling

