




Exploration and Production

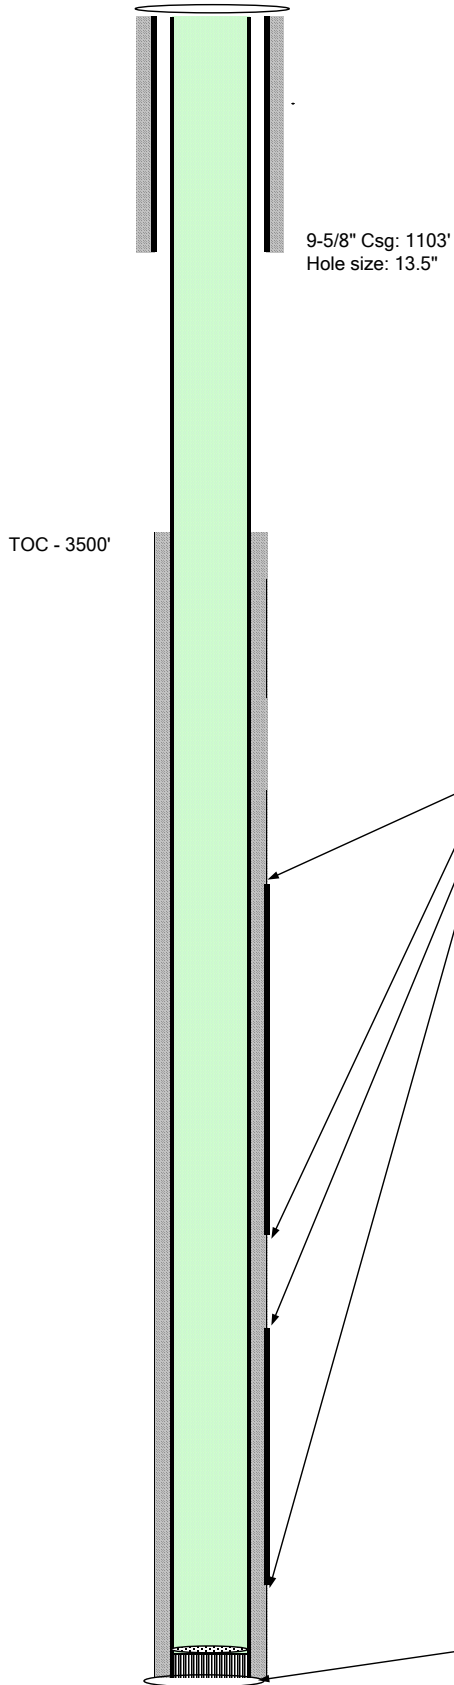

Well Name **GM 434-36**
 Location **SWSE 36 6S 96W**
 Field **Grand Valley**
 County **Garfield, CO**
 API **05-045-14137**
 ELEV **5,439'**
 Footages **838 FSL, 2415 FEL**

4/26/2002

Casing	1103'	9-5/8" 32.3# H-40
Cement	315 sx	
Casing	6872'	4-1/2" 11.6# I-80
Cement	845 sx	

Formation Tops

Mesaverde	3687'
Cameo	6214'

TOC - Bond Log **3500'**

Completed Intervals

	<u>Depth</u>	<u># Holes</u>
<u>MV</u>	5060-6040	56
<u>Cameo</u>	6146-6673	41

TD **6872', 4-1/2" Csg, Hole Size, 7-7/8"**