PIONEER
NATURAL RESOURCES

Downhole Well Profile

Well Name: Lorencito 15-6-34-66

API/UWI	Surface Legal Location	License/Lease Number	Field Name	State
05-071-06975-0000	SWSE 6-34-S-66-W	000231	RATON-LORENCITO	COLORADO

Well Profile	Original KB Elevation (ft)	KB-Ground Distance (ft)	KB-Casing Flange Distance (ft)	KB-Tubing Head Distance (ft)
VERTICAL	0.00	0.00		

Type: POC

Des	Make	Model	WP (psi)	Service	WP Top (psi)	Top Ring Gasket	Bore Min (in)

VERTICAL - Original, 6/30/2015 10:52:24 AM

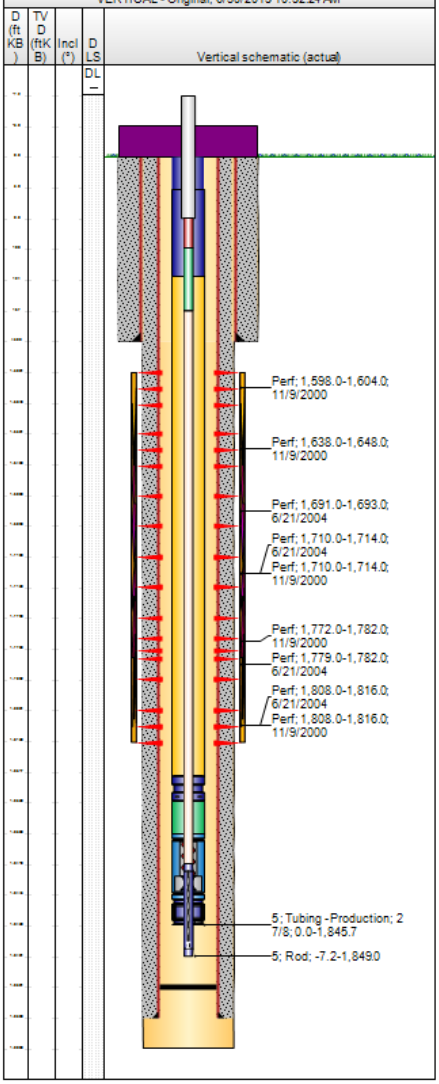

Casing Strings

Description	OD (in)	Wt/Len (lb/ft)	Grade	Top Thread	Set Depth (ftKB)
8 5/8 in casing	8 5/8				459.0
5 1/2 in casing	5 1/2				1,959.0

Perforations

Date	Top (ftKB)	Btm (ftKB)	Zone
11/9/2000	1,598.0	1,604.0	Vermejo, Original
11/9/2000	1,638.0	1,648.0	Vermejo, Original
6/21/2004	1,691.0	1,693.0	Vermejo, Original
6/21/2004	1,710.0	1,714.0	Vermejo, Original
11/9/2000	1,710.0	1,714.0	Vermejo, Original
11/9/2000	1,772.0	1,782.0	Vermejo, Original
6/21/2004	1,779.0	1,782.0	Vermejo, Original
11/9/2000	1,808.0	1,816.0	Vermejo, Original
6/21/2004	1,808.0	1,816.0	Vermejo, Original

Tubing - Production set at 1,845.8ftKB on 4/8/2014 00:00

Tubing Description	Run Date	String Length (ft)	Set Depth (ftKB)
Tubing - Production	4/8/2014	1,845.75	1,845.8

Item Des	Jts	Make	Model	OD (in)	Wt (lb/ft)	Grade	Len (ft)
2 7/8"	1			2 7/8	6.50	J-55	6.00
2 7/8"	1			2 7/8	6.50	J-55	6.00
2 7/8"	57			2 7/8	6.50	J-55	1,819.85
2 7/8"	1			2 7/8	6.50	J-55	1.10
2 7/8"	1			2 7/8	6.50	J-55	4.00
2 7/8"	1			2 7/8	6.50	J-55	7.70
2 7/8"	1			2 7/8	6.50	J-55	1.10

Rod on 4/8/2014 00:00

Rod Description	Run Date	String Length (ft)	Set Depth (ftKB)
Rod	4/8/2014	1,856.23	1,849.0

Item Des	Jts	Make	Model	OD (in)	Wt (lb/ft)	Grade	Len (ft)
polish rod	1			1 1/4			16.00
poney rods	1			7/8			2.00
poney rods	1			7/8			6.00
7/8 rods	73			7/8			1,825.00
roter pump	1			7/8			7.23

Page 1/1 Report Printed: 6/30/2015