




Lat40°, Inc. 1635 Foxtrail Drive, Suite 325 Loveland, CO 970-776-3321

WELL LOCATION CERTIFICATE


THIS MAP DOES NOT REPRESENT A BOUNDARY SURVEY

SECTION: 7
TOWNSHIP: 3N
RANGE: 68W

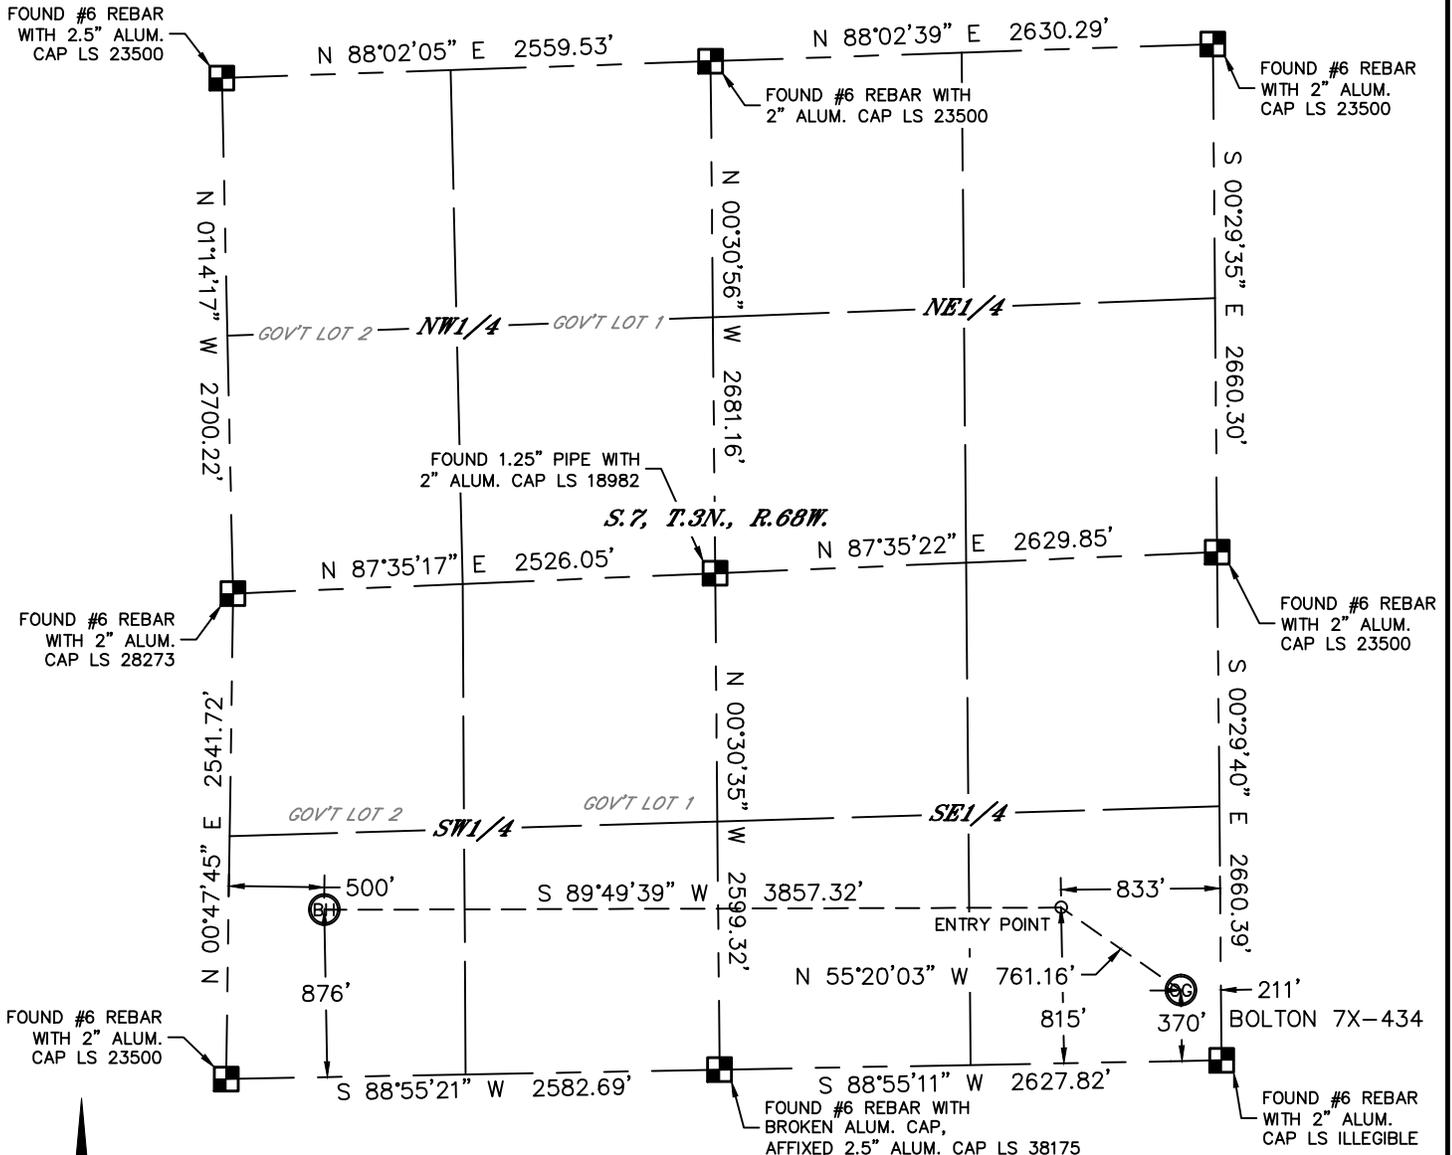

In accordance with a request from Jake Bragg with PDC ENERGY, INC. Lat40°, Inc. has determined the surface location of the BOLTON 7X-434 to be 370' from the SOUTH line and 211' from the EAST line and the bottom hole to be 876' from the SOUTH line and 500' from the WEST line as measured at right angles from the section lines of Section 7, Township 3 North, Range 68 West of the Sixth Principal Meridian, County of Weld, State of Colorado.


I hereby state that this Well Location Certificate was prepared by me, or under my direct supervision, that the fieldwork was completed on 6/12/14, for and on behalf of PDC ENERGY, INC. That this is not a Land Survey Plat or an Improvement Survey Plat, and that it is not to be relied upon for establishment of fence, building, or other future improvement lines.

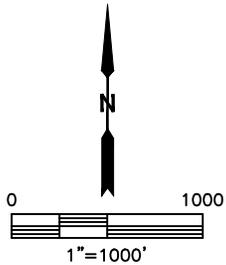

SURFACE LOCATION
LAT: 40.23398°N
LONG: 105.03719°W
PDOP: 2.1
ELEV: 5151'
1/4,1/4: SESE

BOTTOM HOLE
LAT: 40.23520°N
LONG: 105.05324°W

ENTRY POINT
LAT: 40.23518°N
LONG: 105.03943°W

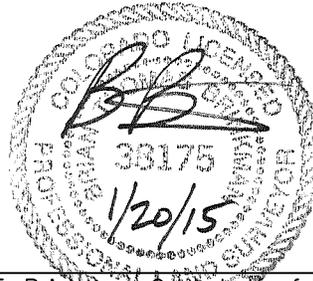

- NOTE:
- 1) Bearings shown are Grid Bearings of the Colorado State Plane Coordinate System, North Zone, North American Datum 1983. The lineal dimensions as contained herein are based upon the "U.S. Survey Foot."
 - 2) Ground elevations are based on an observed GPS elevation (NAVD 1988 DATUM).
 - 3) IMPROVEMENTS: See LOCATION DRAWING for all visible improvements within 500' of disturbed area.
 - 4) SURFACE USE: PASTURE
 - 5) INSTRUMENT OPERATOR: ADAM KELLY
 - 6) NEAREST CULTURAL ITEMS:
BUILDING: 552' NE
BUILDING UNIT: 575' N
HIGH OCCUPANCY BUILDING UNIT: 5280'+
DESIGNATED OUTSIDE ACTIVITY AREA: 5280'+
PUBLIC ROAD: 200' E (CR 3)
ABOVEGROUND UTILITY: 235' E
RAILROAD: 5280'+
PROPERTY LINE: 211' E

LEGEND

- = ALIQUOT MONUMENT AS DESCRIBED
- = CALCULATED POSITION

Brian T. Brinkman, On behalf of Lat40°, Inc.
Colorado Licensed Professional Land Surveyor No. 38175
DATE: 1/20/2015
PROJECT#: 2014102




Lat40°, Inc. 1635 Foxtrail Drive, Suite 325 Loveland, CO 970-776-3321

SITE SKETCH


BOLTON 7X-434

SECTION: 7
TOWNSHIP: 3N
RANGE: 68W

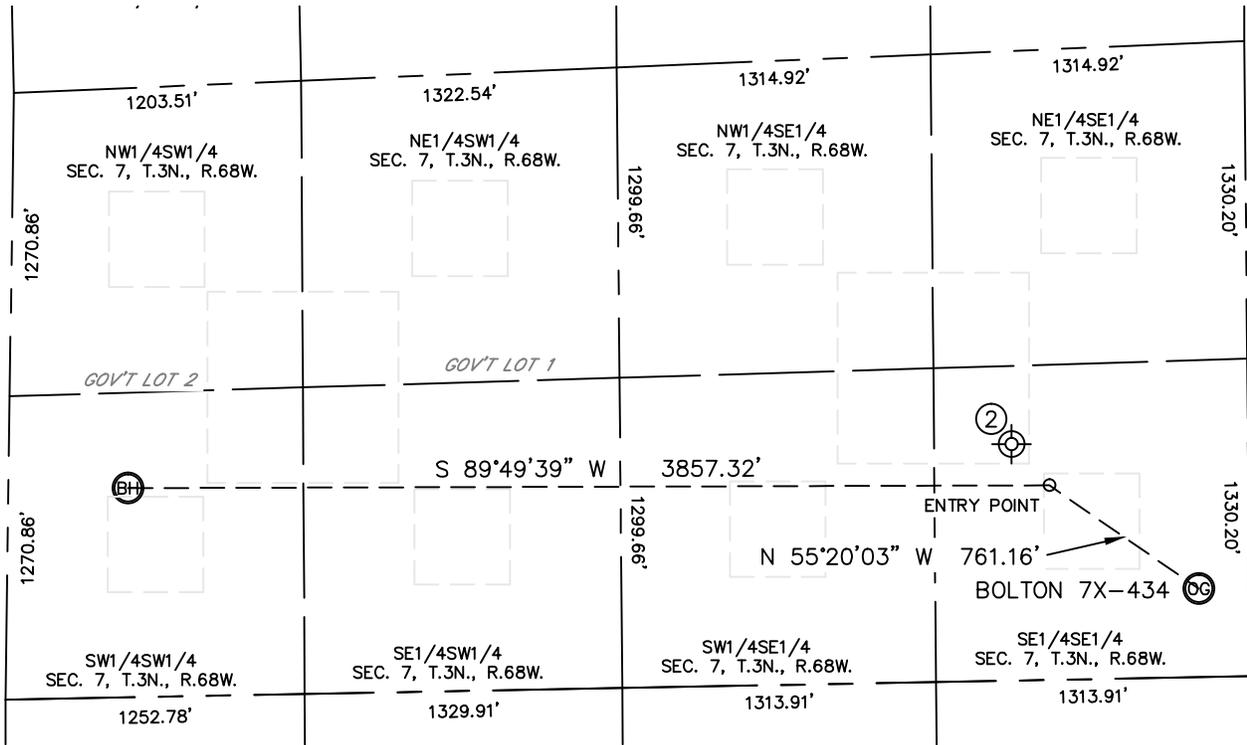

WELL NO.	WELL NAME	SHL FOOTAGE	SHL LAT°	SHL LONG°	PDOP	ELEV (FT.)	1/4/1/4
2	RADIO TOWER 1	990 FSL 990 FEL	40.23563	105.04006	NA	5154	SESE

NOTE: THE ABANDONED WELL DATA SHOWN IN RED ABOVE WAS OBTAINED FROM COGCC SCOUT CARDS.

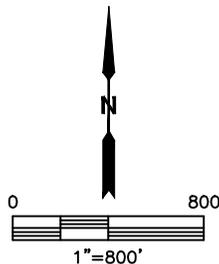

DATE: 1/20/2015
PROJECT#: 2014102