


**Well Name: Timbro Ranch 2-34-10-59**

API/UWI 05-123-40525	Field Name NIOBRARA SHALE	County WELD	State/Province COLORADO	State Plane (E/W - X) (ft) 3,425,551	State Plane (N/S - Y) (ft) 1,532,966
Spud Date 11/15/2014 18:15	Date TD Reached 11/23/2014 21:30	Rig Release Date 11/25/2014 08:30	Original KB Elevation (ft) 5,084	Ground Elevation (ft) 5,067	Total Depth (All) (ftKB)

**HORIZONTAL - ORIGINAL HOLE, 6/18/2015 11:15:46 AM**

Directional schematic (actual)

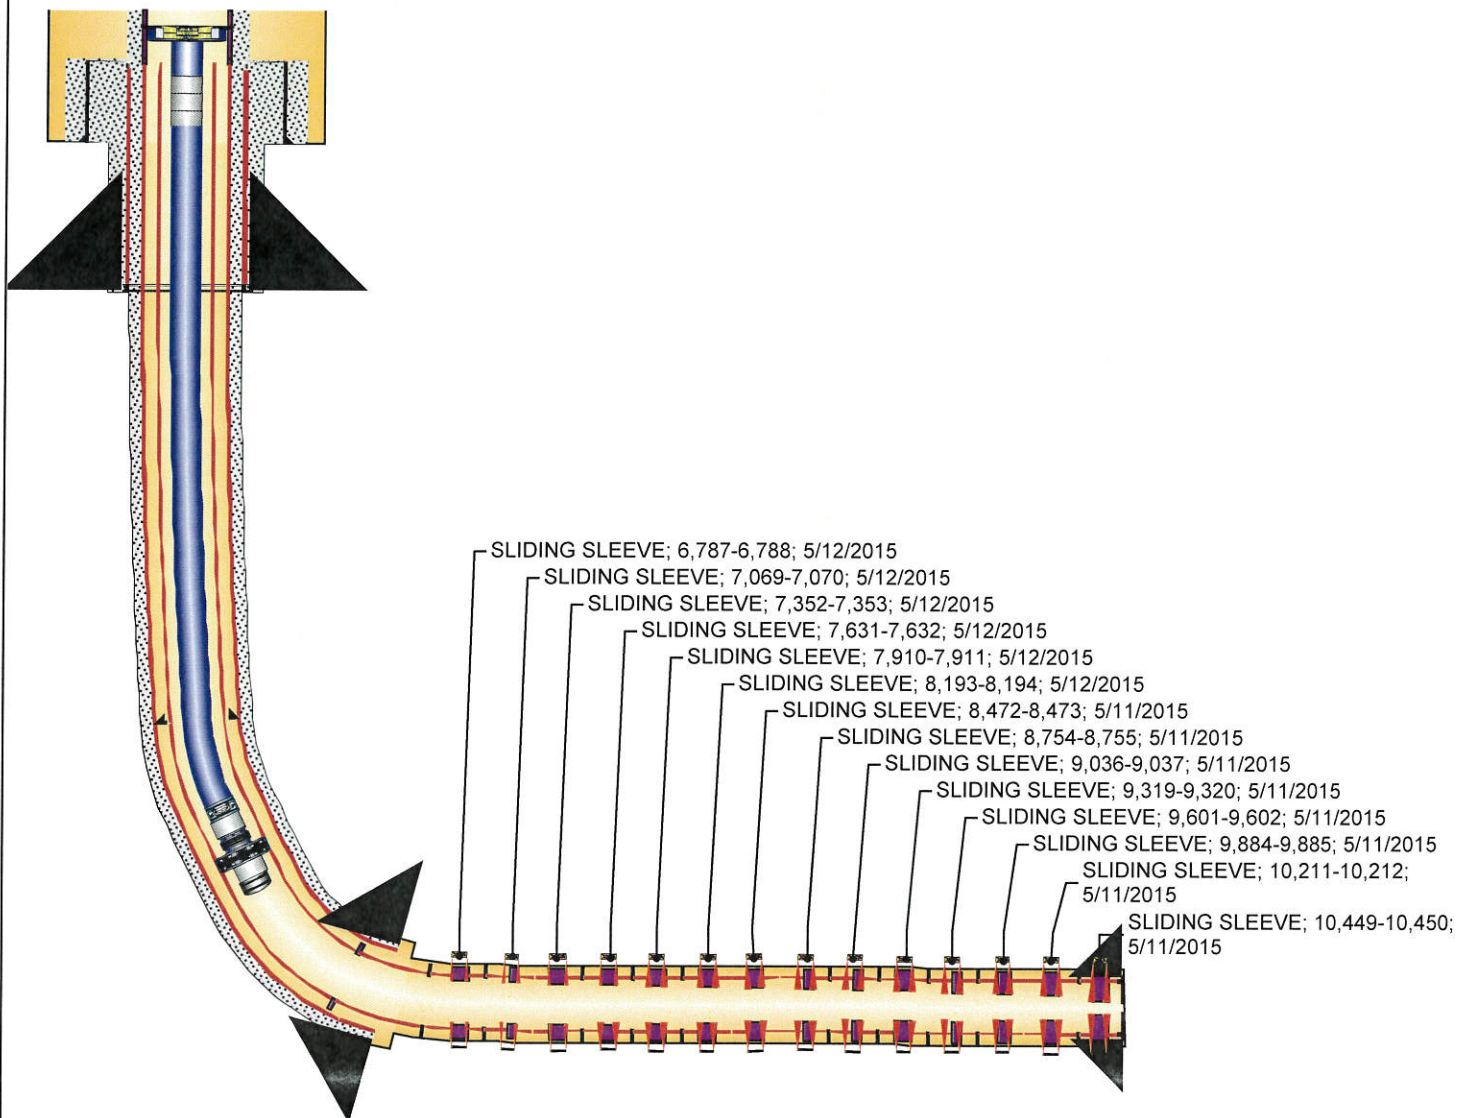

Csg Des	Set Depth (ftKB)	OD (in)	Wt (lb/ft)	Grade	Top Thread
PRODUCTION	10,591	5	11.60	P-110	LT&C