Topographic Spill Map

Turbo 12-33 Spill

PIONEER NATURAL RESOURCES

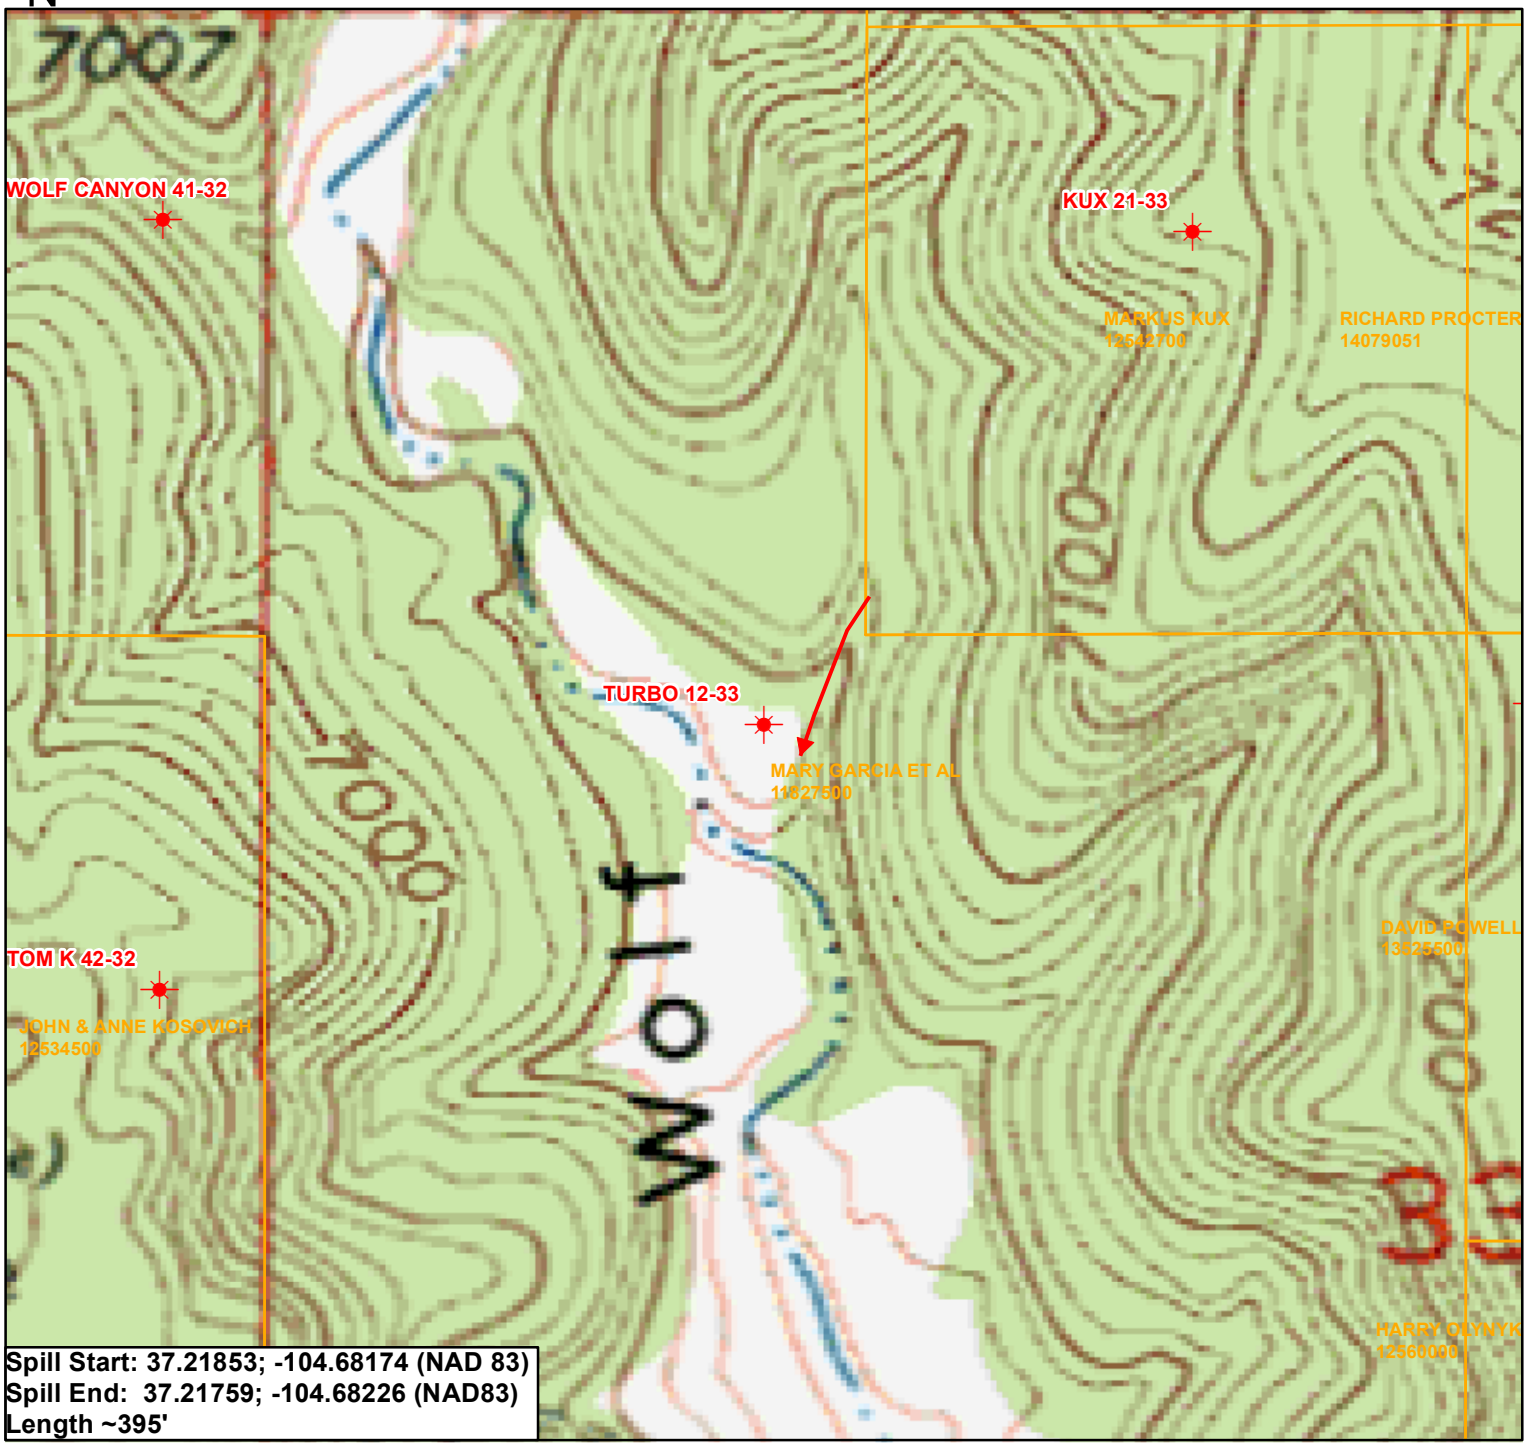

Permitted Well

Spill Path

0 250 500 750 1,000 Feet

1:5,000