

BUSYGULLY 13-54-12-3A

Final WELLBORE SCHEMATIC

3/26/2014

Surface Loc: NENW Sec 12, T13S, R54W

38.933640° & -103.399670° (Nad 83) As Built


BH Loc: NENW Sec 12, T13S, R54W

7120' MD

County: LINCOLN State: COLORADO

7120' TVD

API# 05-073-06494

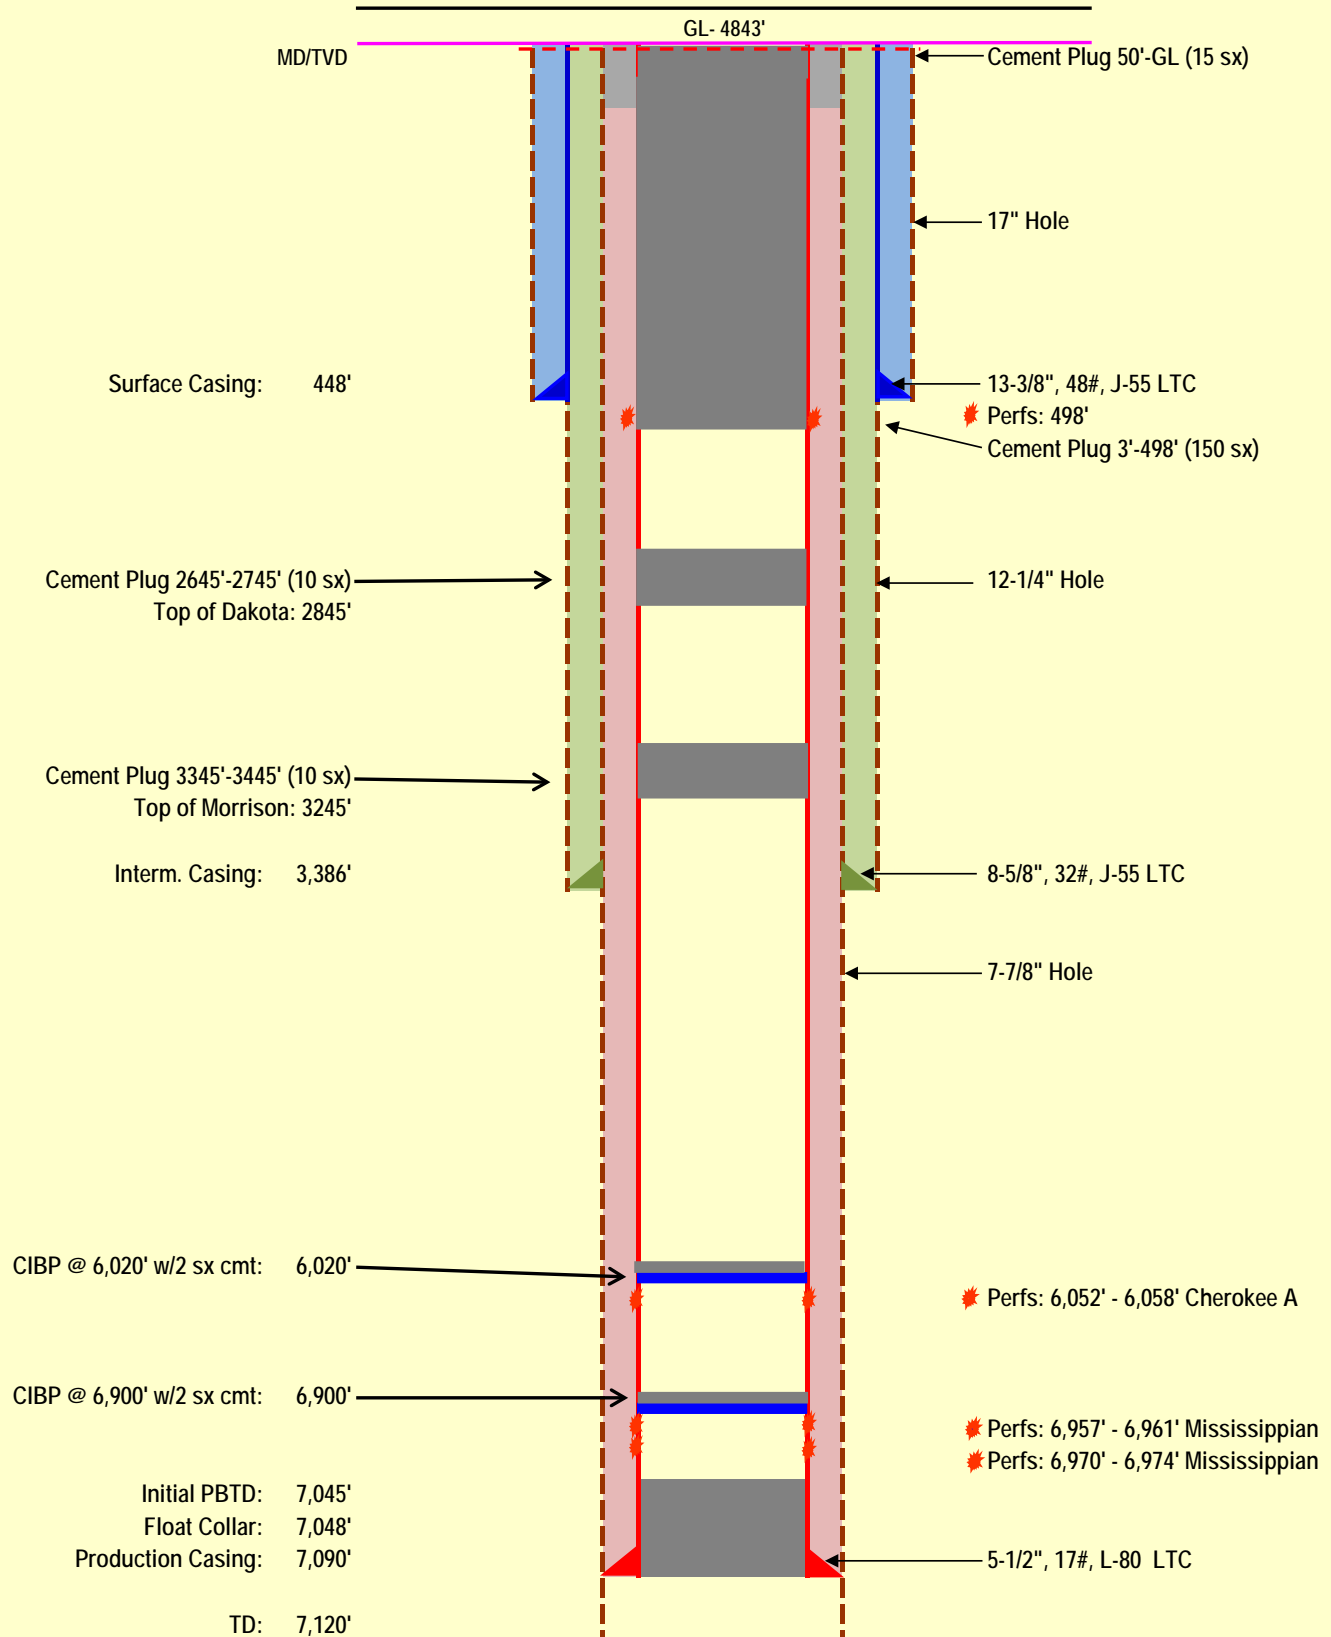

NOT TO SCALE