

Noble Energy

Weld County, CO (NAD 83)

Sec. 26-T9N-59W (Gleason PAD)

Gleason LC26-720

Original Wellbore

Design: Actual Surveys

05-123-40689

Sperry Drilling Services

Standard Report

05 May, 2015

Well Coordinates: 1,507,402.89 N, 3,433,056.65 E (40° 42' 56.66" N, 103° 56' 15.86" W)

Ground Level: 4,888.00 usft

Local Coordinate Origin:

Centered on Well Gleason LC26-720

Viewing Datum:

KB = 24 @ 4912.00usft (H&P 273)

TVDs to System:

N

North Reference:

Grid

Unit System:

Dec-Deg - API - US Survey Feet - Custom

Geodetic Scale Factor Applied

Version: 5000.1 Build: 73

HALLIBURTON

Project: Weld County, CO (NAD 83)
 Site: Sec. 26-T9N-59W (Gleason PAD)
 Well: Gleason LC26-720
 Wellbore: Original Wellbore
 Design: Actual Surveys

Noble Energy





Platted SHL: 500' FSL, 626' FEL
 Platted Lat/Long: 40.715740 N, 103.937740 W
 Location: Sec. 26-T9N-R59W

~7" Casing: 1081 FSL, 633 FEL
 Lat/Long: 40.717391 N, 103.937729 W
 State Planes - CO Northern: 1508004.51 N, 3433049.12 E
 Location: Sec. 26-T9N-R59W

Platted BHL: 330' FSL, 660' FEL
 Lat/Long: 40.728080 N, 103.9380 W
 State Planes - CO Northern: 1511896.75 N, 3432905.39 E
 Location: Sec. 35-T9N-R59W

LEGEND

- ◊ Gleason LC26-720, Original Wellbore, Rev A0 PROPOSAL V0
- Actual Surveys

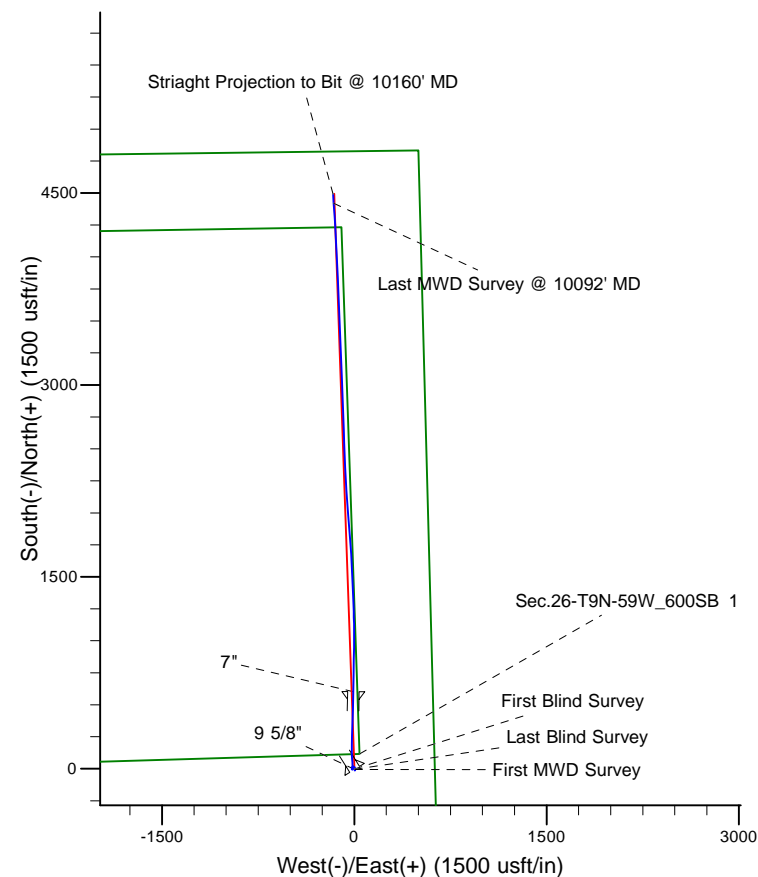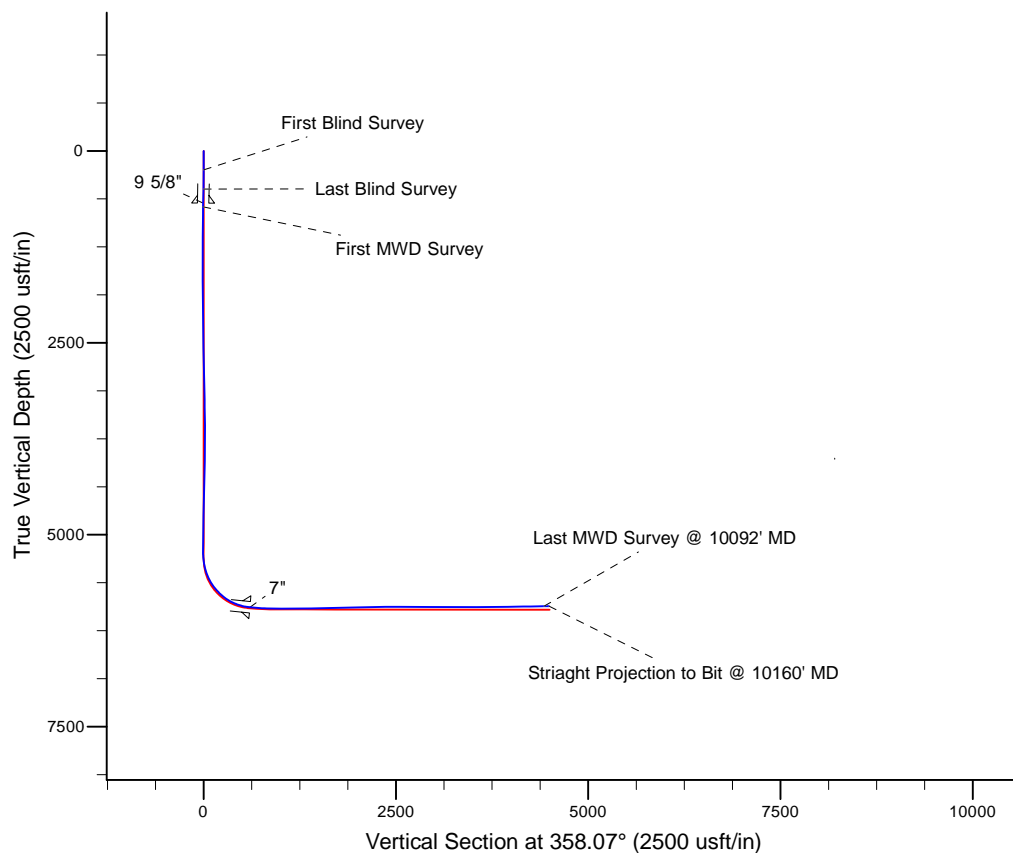

WELL DETAILS: Gleason LC26-720	
Ground Level: 4888.00	
KB = 24 @ 4912.00usft (H&P 273)	
Created By:	Amanda Marchand
Created On:	5/5/2015

Design Report for Gleason LC26-720 - Actual Surveys

Measured Depth (usft)	Inclination (°)	Azimuth (°)	Vertical Depth (usft)	+N/-S (usft)	+E/-W (usft)	Vertical Section (usft)	Dogleg Rate (°/100usft)
0.00	0.00	0.00	0.00	0.00	0.00	0.00	0.00
250.00	0.66	148.09	249.99	-1.22	0.76	-1.25	0.26
First Blind Survey							
500.00	0.66	148.09	499.98	-3.67	2.28	-3.74	0.00
Last Blind Survey							
729.00	0.96	148.09	728.95	-6.41	3.99	-6.55	0.13
First MWD Survey							
824.00	0.65	152.60	823.95	-7.57	4.66	-7.72	0.33
920.00	0.57	177.04	919.94	-8.53	4.94	-8.69	0.28
1,109.00	0.57	182.25	1,108.93	-10.41	4.95	-10.57	0.03
1,386.00	0.74	190.71	1,385.91	-13.54	4.56	-13.69	0.07
1,479.00	0.30	334.63	1,478.91	-13.91	4.35	-14.05	1.07
1,571.00	0.06	45.51	1,570.91	-13.66	4.28	-13.80	0.31
1,664.00	0.09	302.27	1,663.91	-13.59	4.25	-13.72	0.13
1,756.00	0.43	4.63	1,755.91	-13.20	4.22	-13.34	0.43
1,847.00	0.56	3.04	1,846.91	-12.42	4.27	-12.56	0.14
2,125.00	0.83	33.21	2,124.89	-9.38	5.44	-9.56	0.16
2,218.00	0.80	11.07	2,217.88	-8.18	5.94	-8.37	0.34
2,401.00	1.09	9.83	2,400.85	-5.21	6.48	-5.42	0.16
2,494.00	1.04	18.12	2,493.84	-3.54	6.89	-3.77	0.17
2,587.00	1.27	21.92	2,586.82	-1.78	7.54	-2.03	0.26
2,679.00	1.24	15.74	2,678.79	0.13	8.19	-0.15	0.15
2,866.00	1.87	322.69	2,865.73	4.50	6.89	4.27	0.80
2,960.00	1.71	320.90	2,959.69	6.81	5.08	6.63	0.18
3,054.00	1.52	319.67	3,053.65	8.85	3.39	8.73	0.21
3,148.00	1.60	305.39	3,147.62	10.56	1.51	10.50	0.42
3,243.00	1.25	305.21	3,242.59	11.92	-0.42	11.93	0.37
3,338.00	1.31	314.24	3,337.56	13.28	-2.04	13.34	0.22
3,432.00	1.52	313.86	3,431.53	14.89	-3.71	15.01	0.22
3,527.00	1.59	310.83	3,526.50	16.63	-5.62	16.81	0.11
3,622.00	0.91	249.44	3,621.48	17.22	-7.32	17.46	1.48
3,716.00	0.88	255.38	3,715.47	16.78	-8.72	17.06	0.10
3,810.00	0.84	249.85	3,809.46	16.36	-10.06	16.69	0.10
3,906.00	0.75	249.53	3,905.45	15.90	-11.31	16.27	0.09
4,000.00	1.12	231.33	3,999.44	15.11	-12.61	15.52	0.50
4,094.00	1.46	222.39	4,093.41	13.65	-14.13	14.12	0.42
4,188.00	1.68	223.60	4,187.38	11.77	-15.89	12.30	0.24
4,283.00	1.51	213.41	4,282.34	9.71	-17.54	10.30	0.35
4,377.00	1.55	202.49	4,376.31	7.51	-18.71	8.13	0.31
4,471.00	1.69	185.97	4,470.27	4.95	-19.34	5.60	0.52
4,566.00	1.68	176.04	4,565.23	2.17	-19.39	2.82	0.31
4,661.00	1.38	165.00	4,660.19	-0.32	-18.99	0.32	0.44
4,755.00	1.27	154.81	4,754.17	-2.36	-18.26	-1.74	0.28
4,850.00	0.80	142.85	4,849.15	-3.84	-17.41	-3.25	0.54
5,132.00	0.59	146.30	5,131.13	-6.62	-15.42	-6.10	0.08
5,226.00	0.68	171.54	5,225.13	-7.57	-15.06	-7.06	0.31
5,415.00	12.14	0.86	5,412.79	11.27	-14.60	11.75	6.78
5,510.00	20.40	358.34	5,503.91	37.85	-14.93	38.33	8.72
5,604.00	26.67	355.62	5,590.05	75.30	-17.02	75.83	6.77
5,699.00	35.95	359.00	5,671.13	124.55	-19.14	125.13	9.94

Design Report for Gleason LC26-720 - Actual Surveys

Measured Depth (usft)	Inclination (°)	Azimuth (°)	Vertical Depth (usft)	+N/-S (usft)	+E/-W (usft)	Vertical Section (usft)	Dogleg Rate (°/100usft)
5,794.00	43.91	1.10	5,743.92	185.47	-18.99	186.01	8.50
5,888.00	51.04	1.10	5,807.42	254.69	-17.66	255.14	7.59
5,983.00	59.95	1.23	5,861.18	332.88	-16.07	333.24	9.38
6,077.00	68.95	2.74	5,901.68	417.55	-13.09	417.75	9.68
6,172.00	75.23	1.66	5,930.88	507.83	-9.64	507.87	6.70
6,227.00	83.77	1.25	5,940.90	561.84	-8.27	561.80	15.54
6,329.00	85.12	0.34	5,950.77	663.35	-6.86	663.21	1.59
6,424.00	86.08	1.31	5,958.06	758.06	-5.50	757.82	1.43
6,518.00	88.46	0.74	5,962.54	851.93	-3.82	851.58	2.60
6,613.00	87.81	0.65	5,965.63	946.87	-2.67	946.43	0.69
6,707.00	90.65	359.84	5,966.89	1,040.85	-2.26	1,040.34	3.14
6,801.00	91.23	359.72	5,965.35	1,134.84	-2.63	1,134.29	0.63
6,896.00	92.19	358.06	5,962.51	1,229.77	-4.46	1,229.23	2.02
6,990.00	90.65	357.32	5,960.18	1,323.67	-8.25	1,323.19	1.82
7,085.00	91.14	357.68	5,958.70	1,418.56	-12.40	1,418.18	0.64
7,179.00	91.63	357.39	5,956.43	1,512.45	-16.44	1,512.15	0.61
7,274.00	89.94	357.09	5,955.13	1,607.33	-21.01	1,607.12	1.81
7,368.00	90.74	355.99	5,954.57	1,701.15	-26.68	1,701.09	1.45
7,463.00	90.74	356.36	5,953.34	1,795.93	-33.02	1,796.03	0.39
7,557.00	90.86	355.39	5,952.03	1,889.68	-39.78	1,889.95	1.04
7,652.00	91.20	355.35	5,950.32	1,984.35	-47.45	1,984.83	0.36
7,746.00	92.62	355.11	5,947.19	2,077.97	-55.26	2,078.65	1.53
7,840.00	90.77	357.18	5,944.41	2,171.71	-61.58	2,172.55	2.95
7,934.00	90.80	357.02	5,943.12	2,265.58	-66.33	2,266.53	0.17
8,029.00	91.36	357.00	5,941.33	2,360.43	-71.29	2,361.50	0.59
8,123.00	89.63	357.58	5,940.52	2,454.32	-75.73	2,455.48	1.94
8,217.00	89.23	358.07	5,941.45	2,548.25	-79.30	2,549.47	0.67
8,311.00	90.15	358.27	5,941.96	2,642.20	-82.30	2,643.47	1.00
8,405.00	89.94	358.46	5,941.89	2,736.16	-84.98	2,737.47	0.30
8,500.00	90.15	357.80	5,941.81	2,831.11	-88.08	2,832.47	0.73
8,594.00	90.46	357.84	5,941.31	2,925.04	-91.66	2,926.47	0.33
8,689.00	89.08	357.16	5,941.69	3,019.94	-95.80	3,021.46	1.62
8,784.00	88.34	358.13	5,943.83	3,114.84	-99.70	3,116.43	1.28
8,879.00	89.66	357.38	5,945.49	3,209.75	-103.42	3,211.41	1.60
8,973.00	89.88	358.20	5,945.87	3,303.68	-107.05	3,305.41	0.90
9,068.00	90.77	357.49	5,945.33	3,398.61	-110.62	3,400.40	1.20
9,162.00	90.77	357.78	5,944.07	3,492.52	-114.50	3,494.39	0.31
9,257.00	90.34	357.63	5,943.15	3,587.44	-118.30	3,589.39	0.48
9,352.00	91.23	357.68	5,941.84	3,682.35	-122.19	3,684.37	0.94
9,446.00	89.88	357.46	5,940.93	3,776.26	-126.18	3,778.36	1.46
9,541.00	90.28	357.61	5,940.80	3,871.17	-130.26	3,873.36	0.45
9,635.00	90.95	357.40	5,939.79	3,965.07	-134.35	3,967.35	0.75
9,729.00	91.14	356.70	5,938.08	4,058.93	-139.19	4,061.32	0.77
9,824.00	90.68	356.86	5,936.57	4,153.77	-144.53	4,156.28	0.51
9,919.00	90.95	356.68	5,935.22	4,248.61	-149.88	4,251.25	0.34
10,013.00	90.68	356.12	5,933.88	4,342.41	-155.78	4,345.20	0.66
10,092.00	91.54	355.68	5,932.35	4,421.20	-161.43	4,424.12	1.22
Last MWD Survey @ 10092' MD							
10,160.00	91.54	355.68	5,930.52	4,488.98	-166.55	4,492.04	0.00
Straight Projection to Bit @ 10160' MD							

Design Report for Gleason LC26-720 - Actual Surveys

Design Annotations

Measured Depth (usft)	Vertical Depth (usft)	Local Coordinates		Comment
		+N/-S (usft)	+E/-W (usft)	
250.00	249.99	-1.22	0.76	First Blind Survey
500.00	499.98	-3.67	2.28	Last Blind Survey
729.00	728.95	-6.41	3.99	First MWD Survey
10,092.00	5,932.35	4,421.20	-161.43	Last MWD Survey @ 10092' MD
10,160.00	5,930.52	4,488.98	-166.55	Striaight Projection to Bit @ 10160' MD

Vertical Section Information

Angle Type	Target	Azimuth (°)	Origin Type	Origin		Start TVD (usft)
				+N/-S (usft)	+E/-W (usft)	
Target	Gleason LC26-720_Rev A0_BH	358.07	Slot	0.00	0.00	0.00

Survey tool program

From (usft)	To (usft)	Survey/Plan	Survey Tool
250.00	500.00	Blind Surveys	BLIND
729.00	6,227.00	Intermediate Surveys	MWD
6,329.00	10,160.00	Production Surveys	MWD

Casing Details

Measured Depth (usft)	Vertical Depth (usft)	Name	Casing Diameter (")	Hole Diameter (")
682.00	681.96	9 5/8"	9-5/8	13-1/16
6,267.00	5,945.05	7"	7	8-3/4

Wellbore Targets

Target Name	Dip Angle (°)	Dip Dir. (°)	TVD (usft)	+N/-S (usft)	+E/-W (usft)	Northing (usft)	Easting (usft)	Latitude	Longitude
- hit/miss target									
- Shape									
Gleason LC26-720_St	0.00	0.00	0.00	0.02	0.00	1,507,402.91	3,433,056.65	40.715740	-103.937740
- actual wellpath misses target center by 0.02usft at 0.00usft MD (0.00 TVD, 0.00 N, 0.00 E)									
- Point									
Gleason LC26-720_Re	0.00	0.00	5,980.00	4,493.91	-151.26	1,511,896.75	3,432,905.39	40.728080	-103.938000
- actual wellpath misses target center by 52.02usft at 10160.00usft MD (5930.52 TVD, 4488.98 N, -166.55 E)									
- Point									

Directional Difficulty Index

Average Dogleg over Survey:	1.39 °/100usft	Maximum Dogleg over Survey:	15.54 °/100usft at 6,227.00 usft
Net Tortousity applicable to Plans:	0.50 °/100usft	Directional Difficulty Index:	6.044

Audit Info

North Reference Sheet for Sec. 26-T9N-59W (Gleason PAD) - Gleason LC26-720 - Original Wellbore

All data is in US Feet unless otherwise stated. Directions and Coordinates are relative to Grid North Reference.

Vertical Depths are relative to KB = 24 @ 4912.00usft (H&P 273). Northing and Easting are relative to Gleason LC26-720

Coordinate System is US State Plane 1983, Colorado Northern Zone using datum North American Datum 1983, ellipsoid GRS 1980

Projection method is Lambert Conformal Conic (2 parallel)

Central Meridian is -105.500000°, Longitude Origin:0.000000°, Latitude Origin:40.783333°

False Easting: 3,000,000.00usft, False Northing: 1,000,000.00usft, Scale Reduction: 0.99998973

Grid Coordinates of Well: 1,507,402.89 usft N, 3,433,056.65 usft E

Geographical Coordinates of Well: 40° 42' 56.66" N, 103° 56' 15.86" W

Grid Convergence at Surface is: 1.01°

Based upon Minimum Curvature type calculations, at a Measured Depth of 10,160.00usft the Bottom Hole Displacement is 4,492.07usft in the Direction of 357.88° (Grid).

Magnetic Convergence at surface is: -7.03° (6 March 2015, , BGGM2014)

