WELLBORE SCHEMATIC

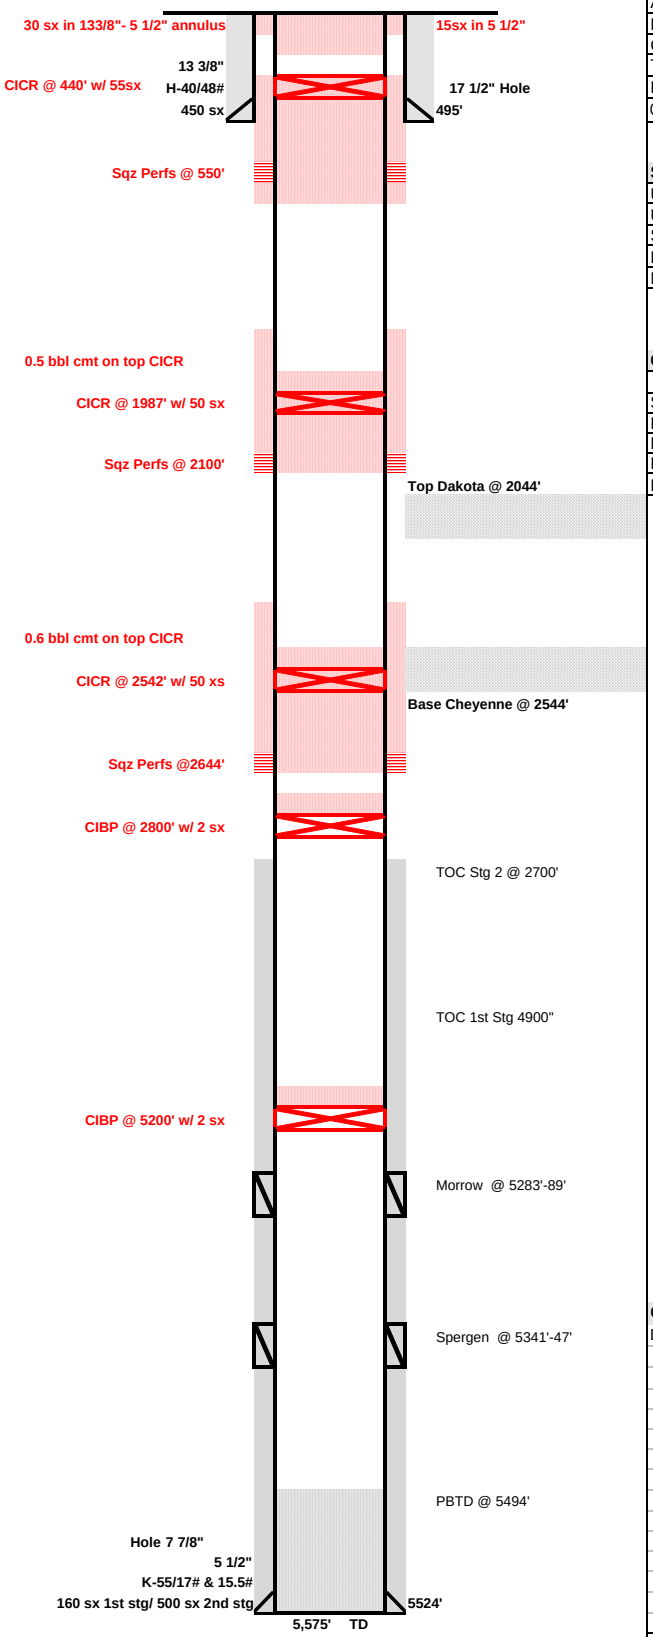

Lease:	**Champlin Kirschmer Unit**			Well No.	**Champlin Kirschmer #1**
API No.	05-063-06049			Current Status	P&A'd
Location:	SW,SW,SEC 21-11s-44w 660' FSL 660' FWL				
County:	Kit Carson	State:	CO	Field:	Lookout
TD	5575'	GL	4220'	Spud Date:	6/10/1978
PBTD	surface	KB	4230'	Comp Date:	7/6/1978
Current Perfs/OH:	NA	Current Zone:			NA

Surface Equipment

Unit Make:		Unit Size:	
Unit S/N:		Unit Rotation:	
SPM:	Stroke Length:	Unit Sheave:	
Prime Mover:		Motor Sheave:	
Motor S/N:		Motor RPM:	

Casing Breakdown

	Size	Grade / Wt	Depth	Hole Size	Cement
Surface	13 3/8"	H-40/48#	495'	17 1/2"	450 sx
Production	5 1/2"	K-55/17# & 15.5#	5524'	7 7/8"	160 sx 1st stg/ 500 sx 2nd stg
Production					
Production					
Liner					

Tubing Breakdown

Qty	Description	Footage
		5209.08'
		5.80'
		62.52'
		1.10'
		31.27'
		5.69'
	TOTAL	**5315.46'**

Rod Breakdown

Qty	Description	Footage
	TOTAL	**0.00'**

Comments

Dakota and Cheyenne sands were correlaated of of the Champlin Pierson#1

PREPARED BY: UPDATED: