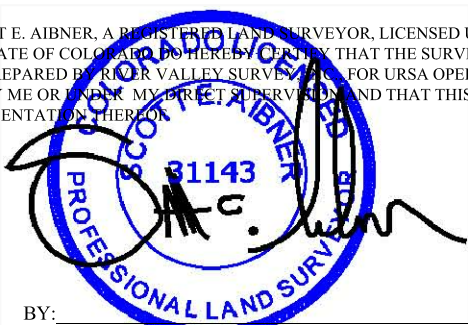


### Notes:

1. LATITUDE AND LONGITUDE COORDINATES ARE DIFFERENTIALLY CORRECTED AND BASED ON PUBLISHED NGS CONTROL STATION "WDP-5". SYSTEM: UTM ZONE: 13 NORTH DATUM: NAD 1983 (CONUS)
2. ELEVATIONS ARE BASED ON NAVD OF 1988.
3. ALL BOTTOM AND TOP HOLE LOCATIONS ARE MEASURED 90 DEGREES FROM SECTION LINE.
4. USGS QUADRANGLE MAP "PARACHUTE".
5. CURRENT SURFACE LAND USE: GAS PAD.
6. PDOP AT THE TIME OF LOCATION OF SURFACE WELL = 1.5

### SURVEYOR'S CERTIFICATE

I, SCOTT E. AIBNER, A REGISTERED LAND SURVEYOR, LICENSED UNDER THE LAWS OF THE STATE OF COLORADO, DO HEREBY CERTIFY THAT THE SURVEY SHOWN HEREON WAS PREPARED BY RIVER VALLEY SURVEY, INC. FOR Ursa OPERATING COMPANY, LLC, BY ME OR UNDER MY DIRECT SUPERVISION AND THAT THIS PLAT IS A TRUE REPRESENTATION THEREOF.

BY: 

SCOTT E. AIBNER, COLORADO REG. NO. 31143

Prepared For Ursa Operating Company, LLC  
As Drilled 11D-17-95 Well, Surface Situate in The  
NW 1/4 SW 1/4 Section 17, Township 7 South, Range  
95 West of the 6 th. Principal Meridian, County of  
Garfield, State of Colorado.



**River Valley Survey, Inc.**  
110 East 3rd. Street, Suite 213  
Rifle, Colorado 81650  
Ph: 970-379-7846

Project: RVS 06001-60

Field Date: 3-04-15

Date: 5-12-15

Scale: 1" = 1000'

Sheet: 1 of 1

**Yater Pad**  
**As-Drilled Plat**  
**11D-17-07-95**

Section 17, Township 7 South, Range 95 West