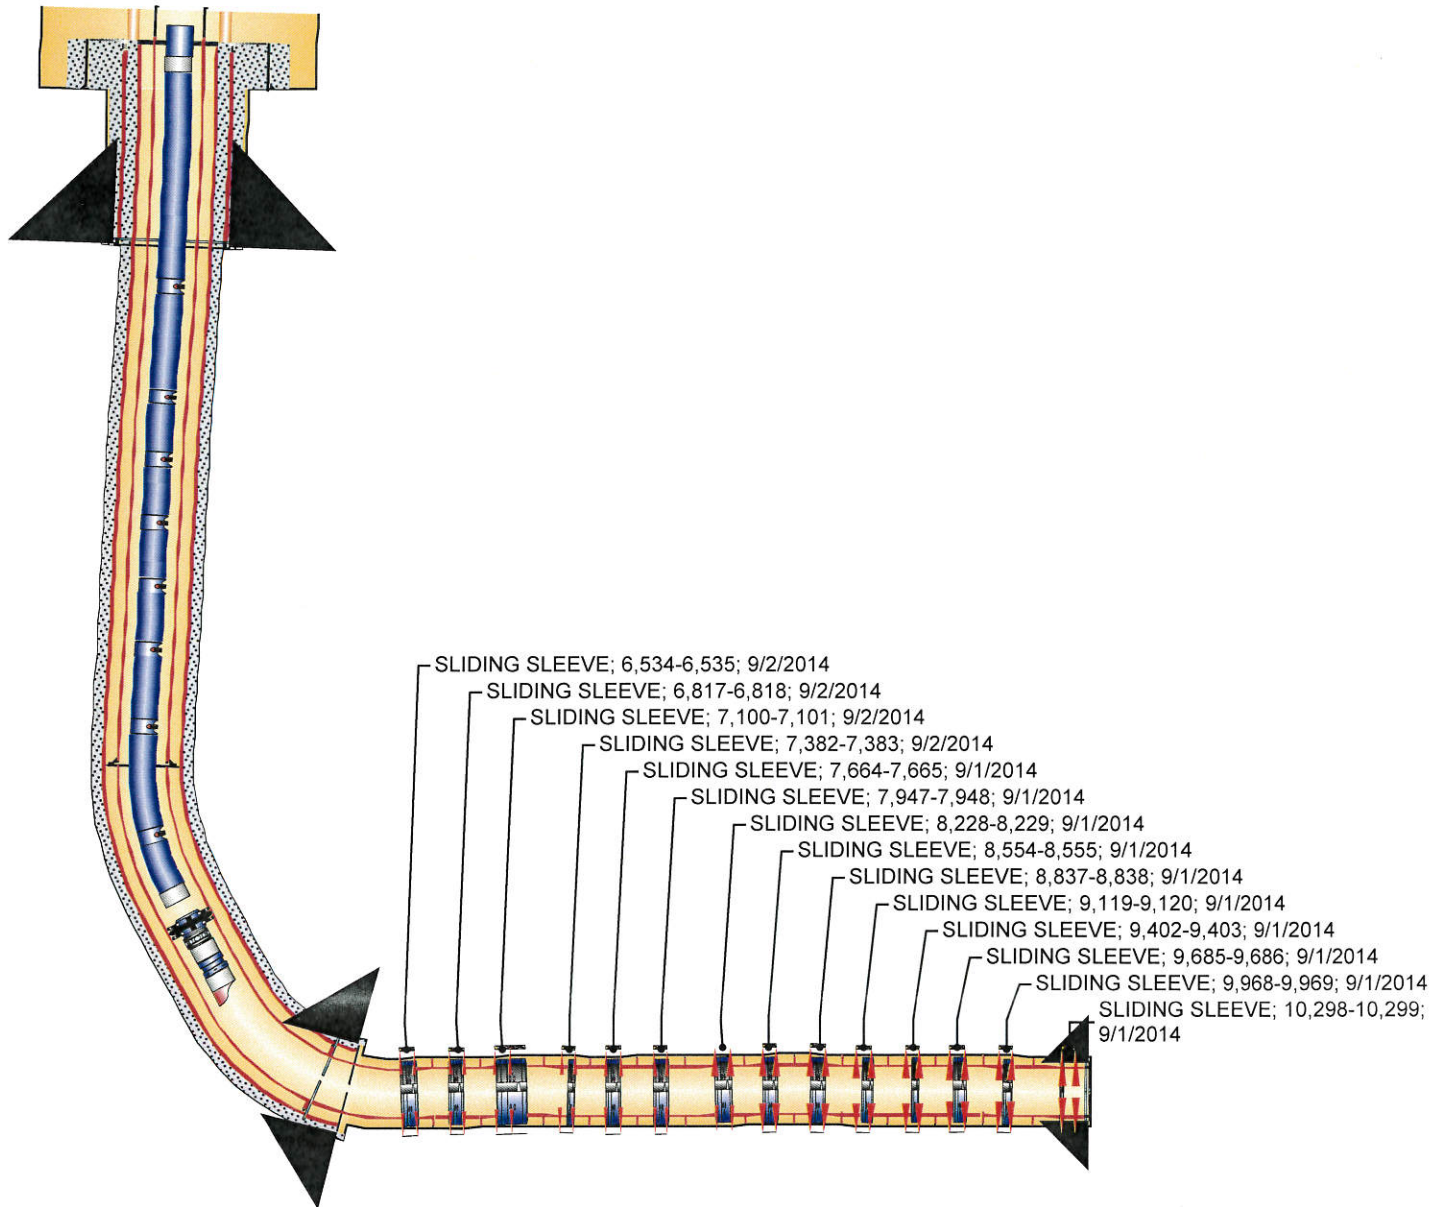


Well Name: Hemberger 3-25-8-60

API/UWI 05-123-39443	Field Name NIOBRARA SHALE	County WELD	State/Province COLORADO	State Plane (E/W - X) (ft) 3,403,480	State Plane (N/S - Y) (ft) 1,474,619
Spud Date 6/28/2014 02:00	Date TD Reached 7/6/2014 13:00	Rig Release Date 7/8/2014 06:00	Original KB Elevation (ft) 4,926	Ground Elevation (ft) 4,909	Total Depth (All) (ftKB)

HORIZONTAL - ORIGINAL HOLE, 3/4/2015 1:06:01 PM
Directional schematic (actual)


Csg Des	Set Depth (ftKB)	OD (in)	Wt (lb/ft)	Grade	Top Thread
LINER	10,437	5	11.60	P-110	LT&C