


**Well Name: Bringelson Ranch 5-34-9-58**

API/UWI 05-123-39948	Field Name NIOBRARA SHALE	County WELD	State/Province COLORADO	State Plane (E/W - X) (ft) 3,455,633	State Plane (N/S - Y) (ft) 1,507,137
Spud Date 8/7/2014 10:30	Date TD Reached 8/14/2014 14:00	Rig Release Date 8/16/2014 12:00	Original KB Elevation (ft) 4,822	Ground Elevation (ft) 4,805	Total Depth (All) (ftKB)

**HORIZONTAL - ORIGINAL HOLE, 10/16/2014 8:45:22 AM**

Directional schematic (actual)

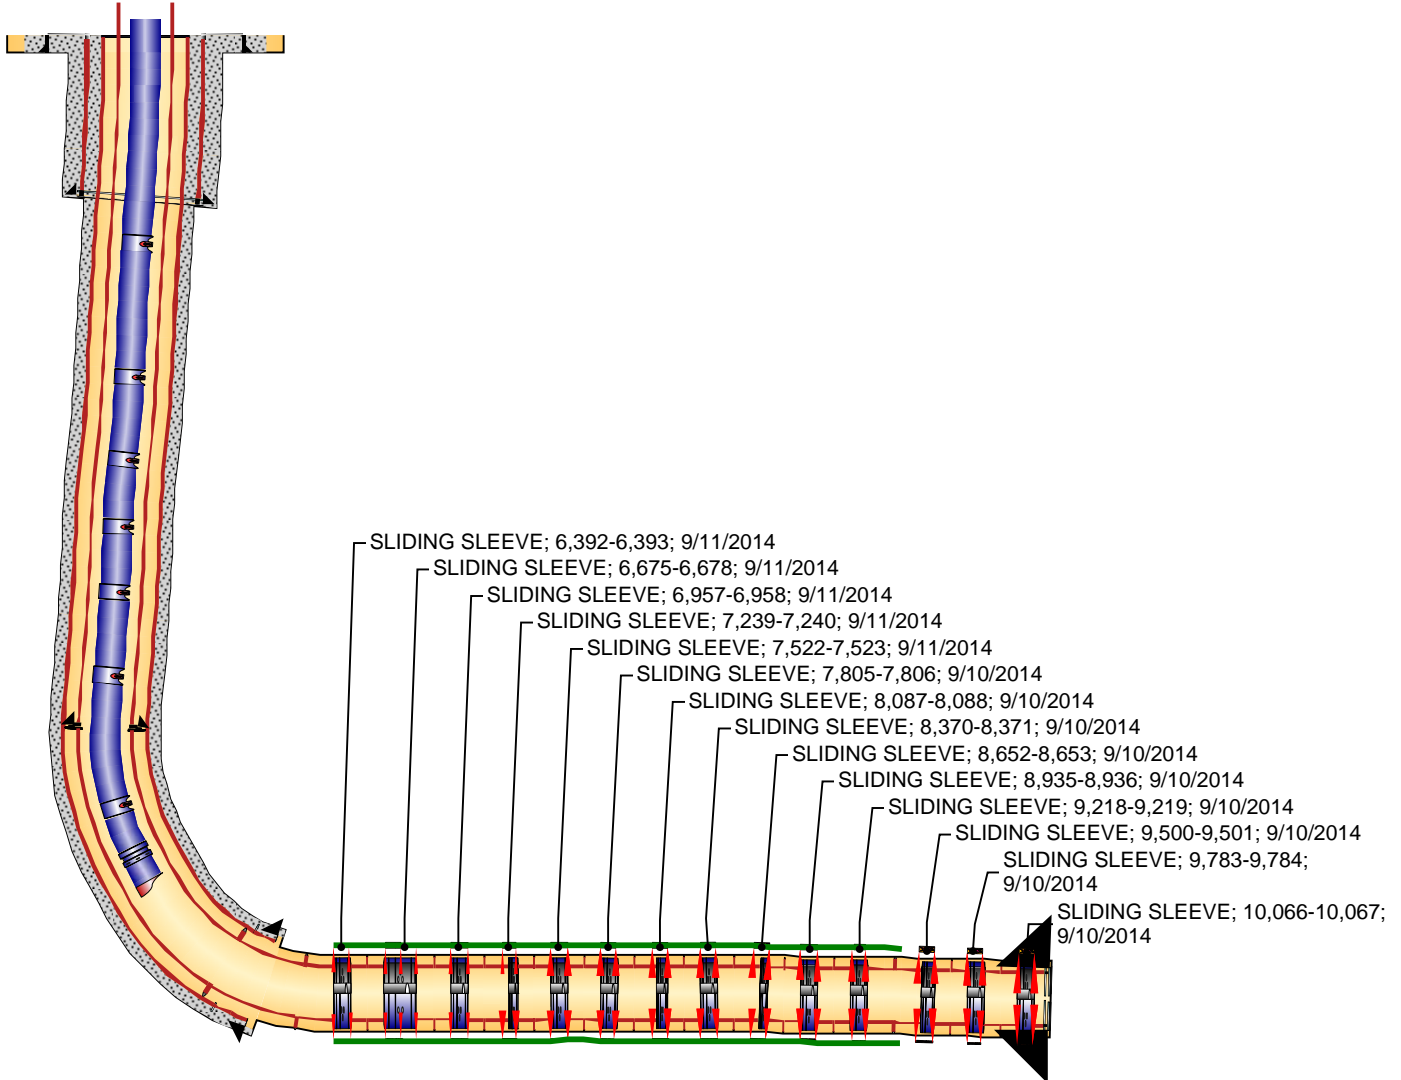

Csg Des	Set Depth (ftKB)	OD (in)	Wt (lb/ft)	Grade	Top Thread
PRODUCTION	10,208	5	11.60	P-110	LT&C