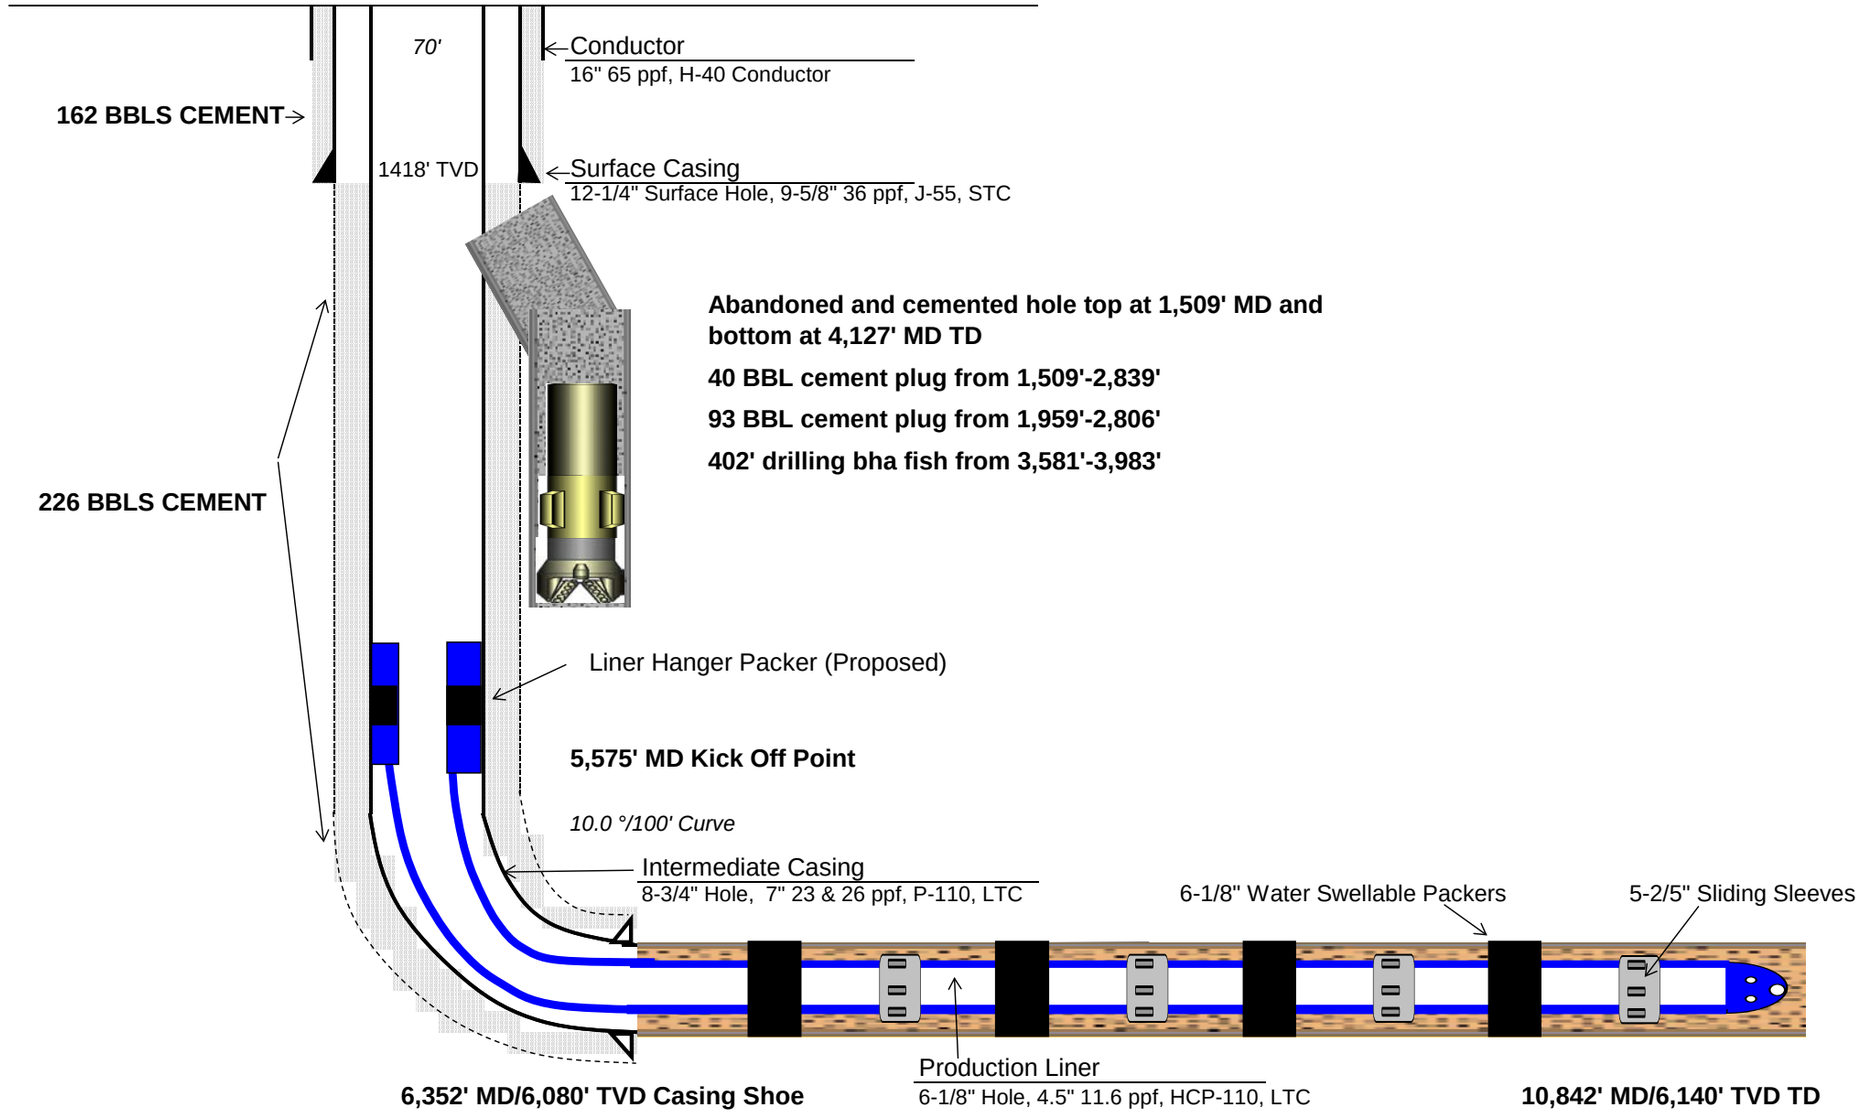Shull 4-25-9-60 WELLBORE DIAGRAM - AS DRILLED