



PDC Energy  
 Goodell 1  
 NENE 21 7N 66W  
 Weld County, CO

P&A Wellbore Schematic - NOT TO SCALE!!!  
 5/7/2013


API#: 05-123-07417

GL Elevation: 4961

Surface Casing:
8 5/8" 24# @ 229' w/ 150sx cmt.

Production Casing:
4 1/2" 11.6# @ 8105' w/ 250 sks

Perforations:	
	Jsnd 8019'-8043'
Old:	0
	0
	0
	0
New:	0
	0
	0
	0

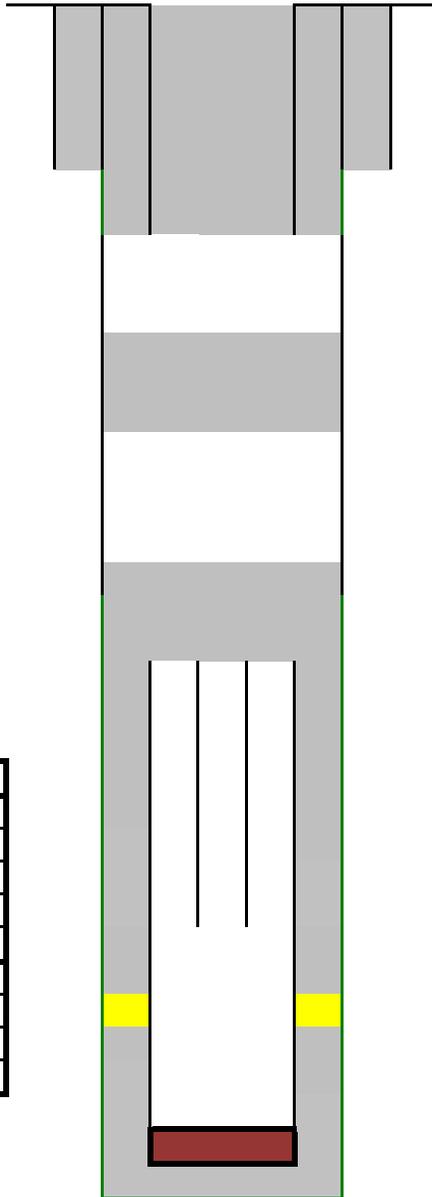

CICR @ 3850'

Top of Fish 7311'

JSND

PBTD:	8069
Casing TD:	8105

NOTES

Re-entry: Top of Fish @ 7311'; mix and pump 25.5 bbls of cement to 6831'. Pull up to 4520', pump 108 bbls of cement tag top of cement @ 3230'. Pull up to 655' pump 65 bbls of cement tag TOC @ 36'. Cut and cap well.

