

WELLBORE DIAGRAM

Duncan Oil, Inc

BK 1

SWNE Sec 34-T3S-R53W


Washington County , CO

05-121-11050

As Plugged

10/7/2015

PAG

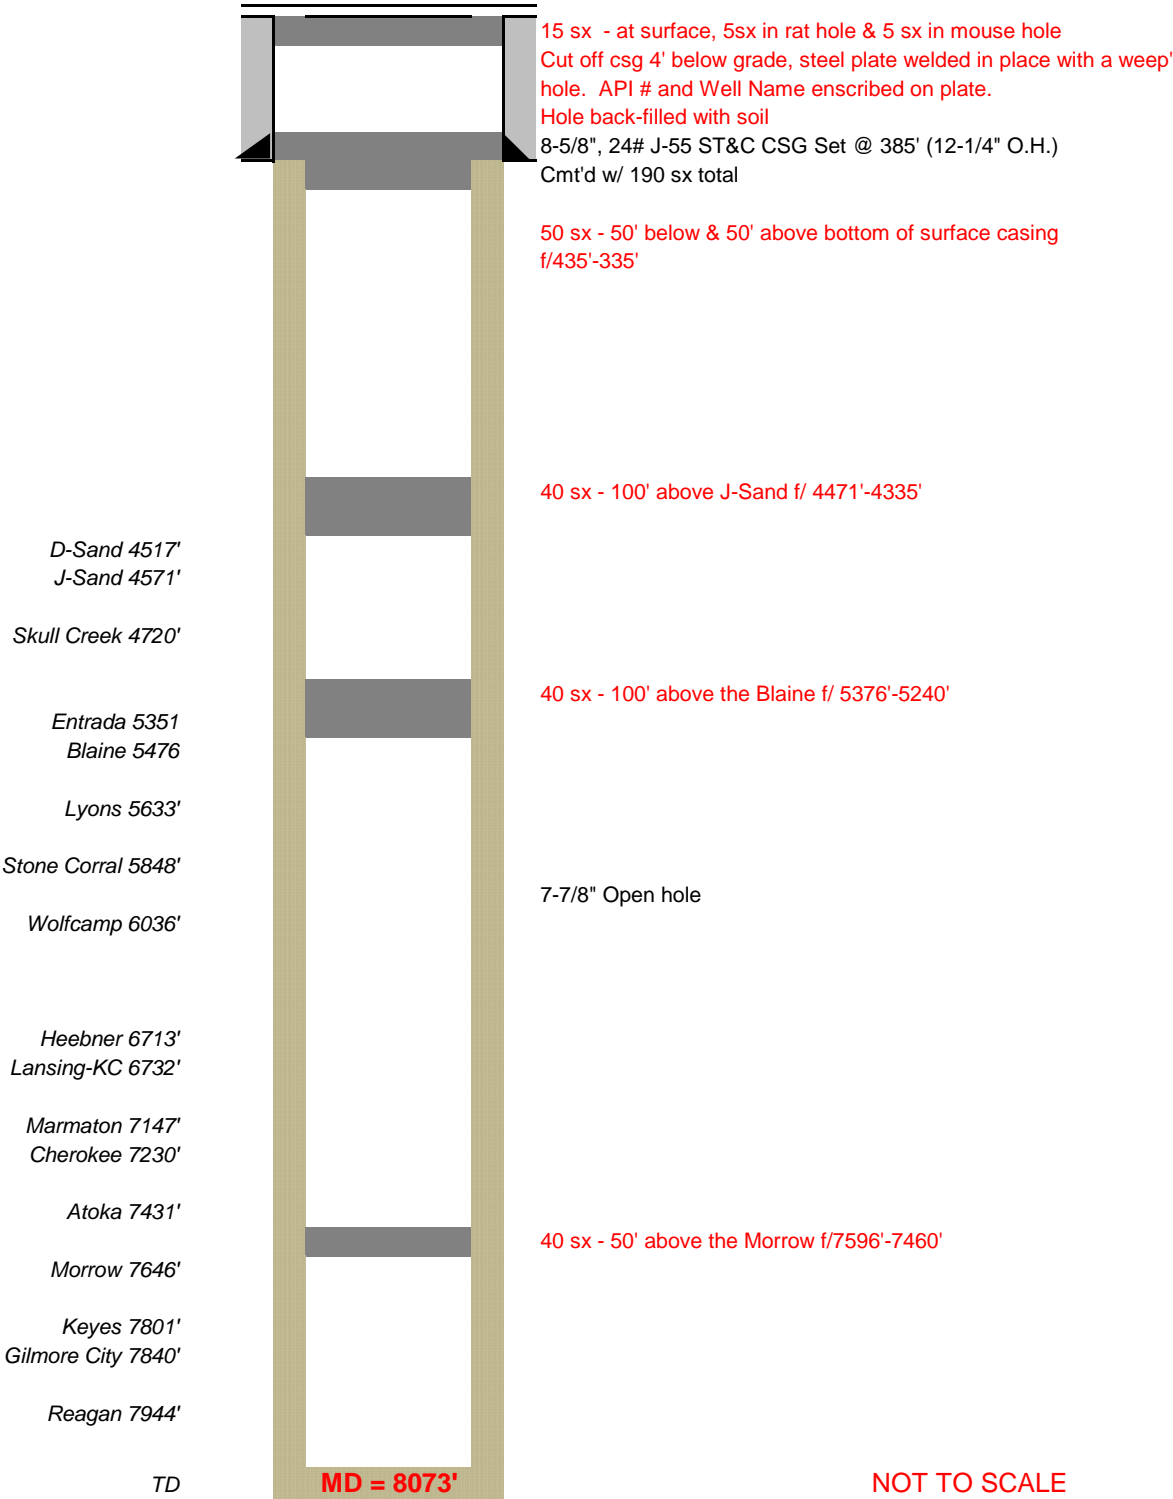

NOT TO SCALE