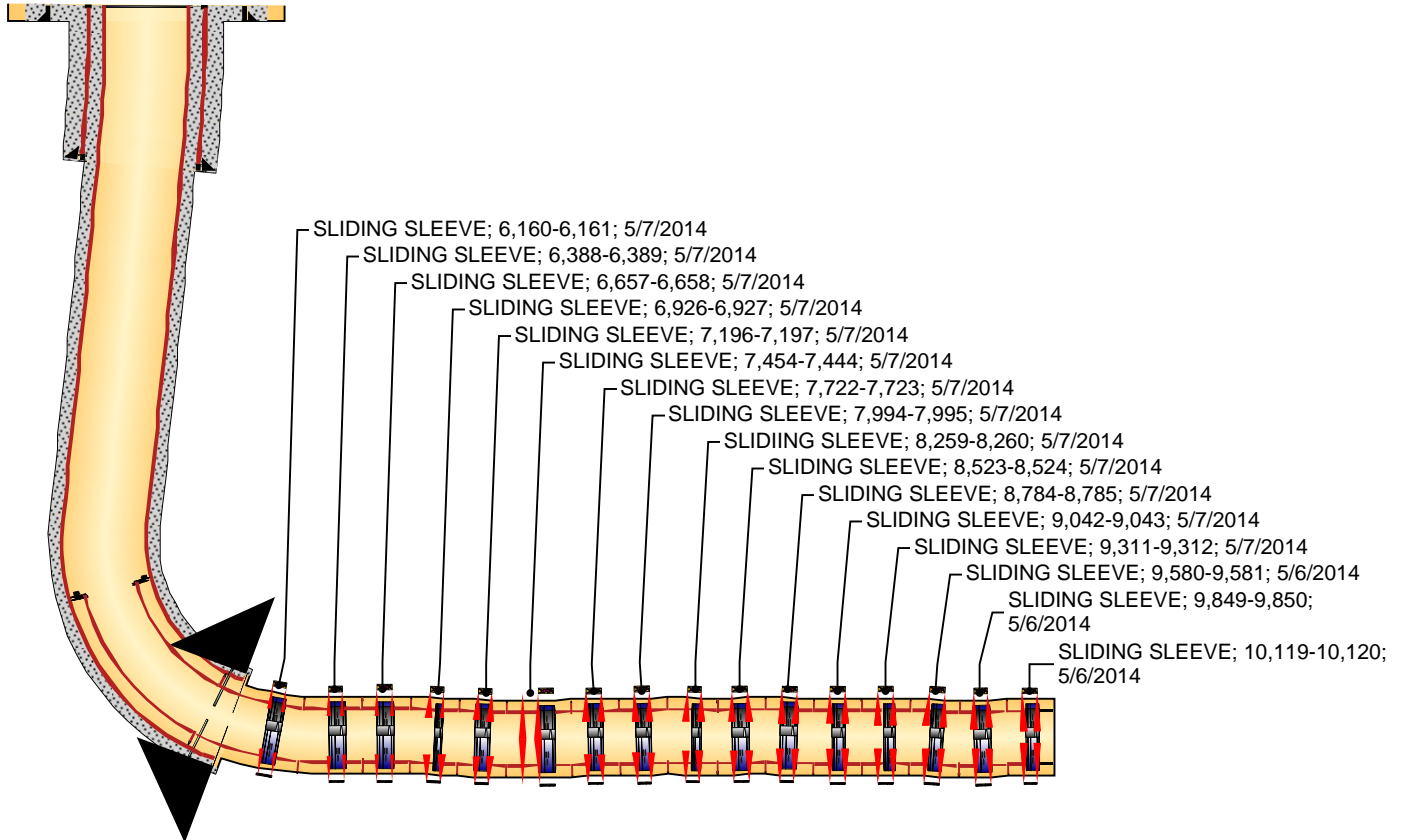


Well Name: Bringelson Ranch 5-20-9-58

| | | | | | |
|-----------------------------|------------------------------------|-------------------------------------|-------------------------------------|---|---------------------------------------|
| API/UWI 05-123-38583 | Field Name NIOBRARA SHALE | County WELD | State/Province COLORADO | State Plane (E/W - X) (ft) 3,444,614 | State Plane (N/S - Y) (ft) 151,338 |
| Spud Date 1/7/2014 22:30 | Date TD Reached 1/16/2014 04:30 | Rig Release Date 1/18/2014 06:00 | Original KB Elevation (ft) 4,872 | Ground Elevation (ft) 4,855 | Total Depth (All) (ftKB) |

HORIZONTAL - ORIGINAL HOLE, 5/29/2014 10:22:40 AM
Directional schematic (actual)


| Csg Des | Set Depth (ftKB) | OD (in) | Wt (lb/ft) | Grade | Top Thread |
|---------|------------------|---------|------------|-------|------------|
| LINER | 10,213 | 0.0 | 11.60 | P-110 | LT&C |