


**Well Name: Bringelson Ranch 7-20-9-58**

API/UWI 05-123-38584	Field Name NIOBRARA SHALE	County WELD	State/Province COLORADO	State Plane (E/W - X) (ft) 3,444,641	State Plane (N/S - Y) (ft) 1,513,364
Spud Date 2/9/2014 21:30	Date TD Reached 2/17/2014 01:15	Rig Release Date 2/18/2014 20:00	Original KB Elevation (ft) 4,872	Ground Elevation (ft) 4,855	Total Depth (All) (ftKB)

## HORIZONTAL - ORIGINAL HOLE, 9/4/2014 9:48:26 AM

Directional schematic (actual)

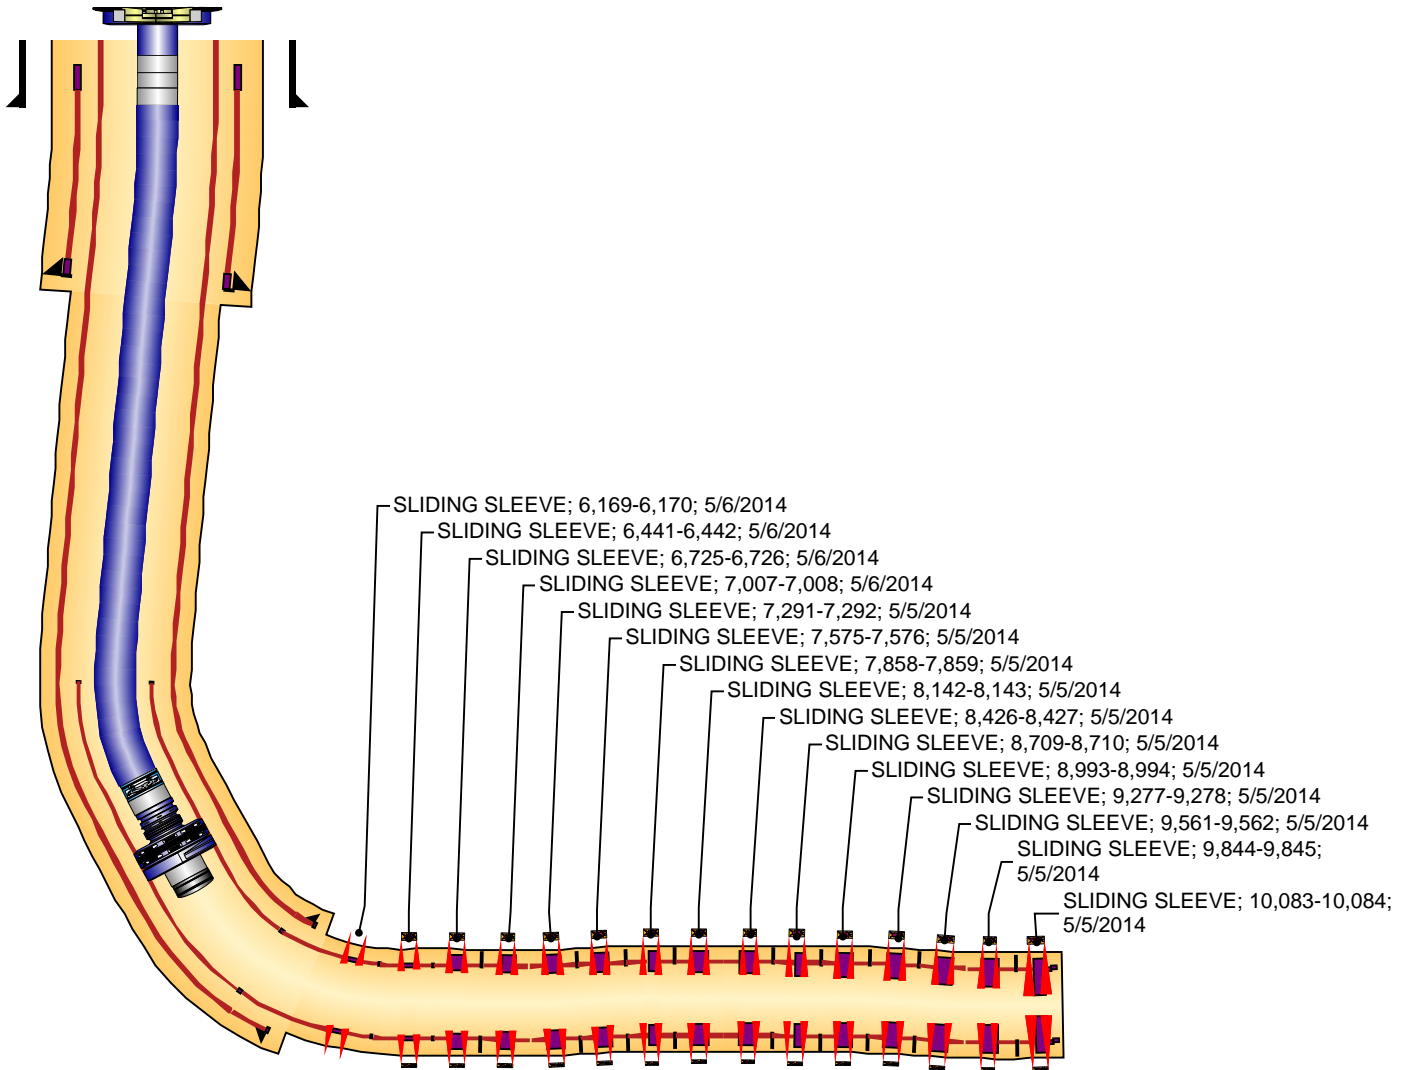

Csg Des	Set Depth (ftKB)	OD (in)	Wt (lb/ft)	Grade	Top Thread
LINER	10,181	0.0	11.60	P-110	LT&C