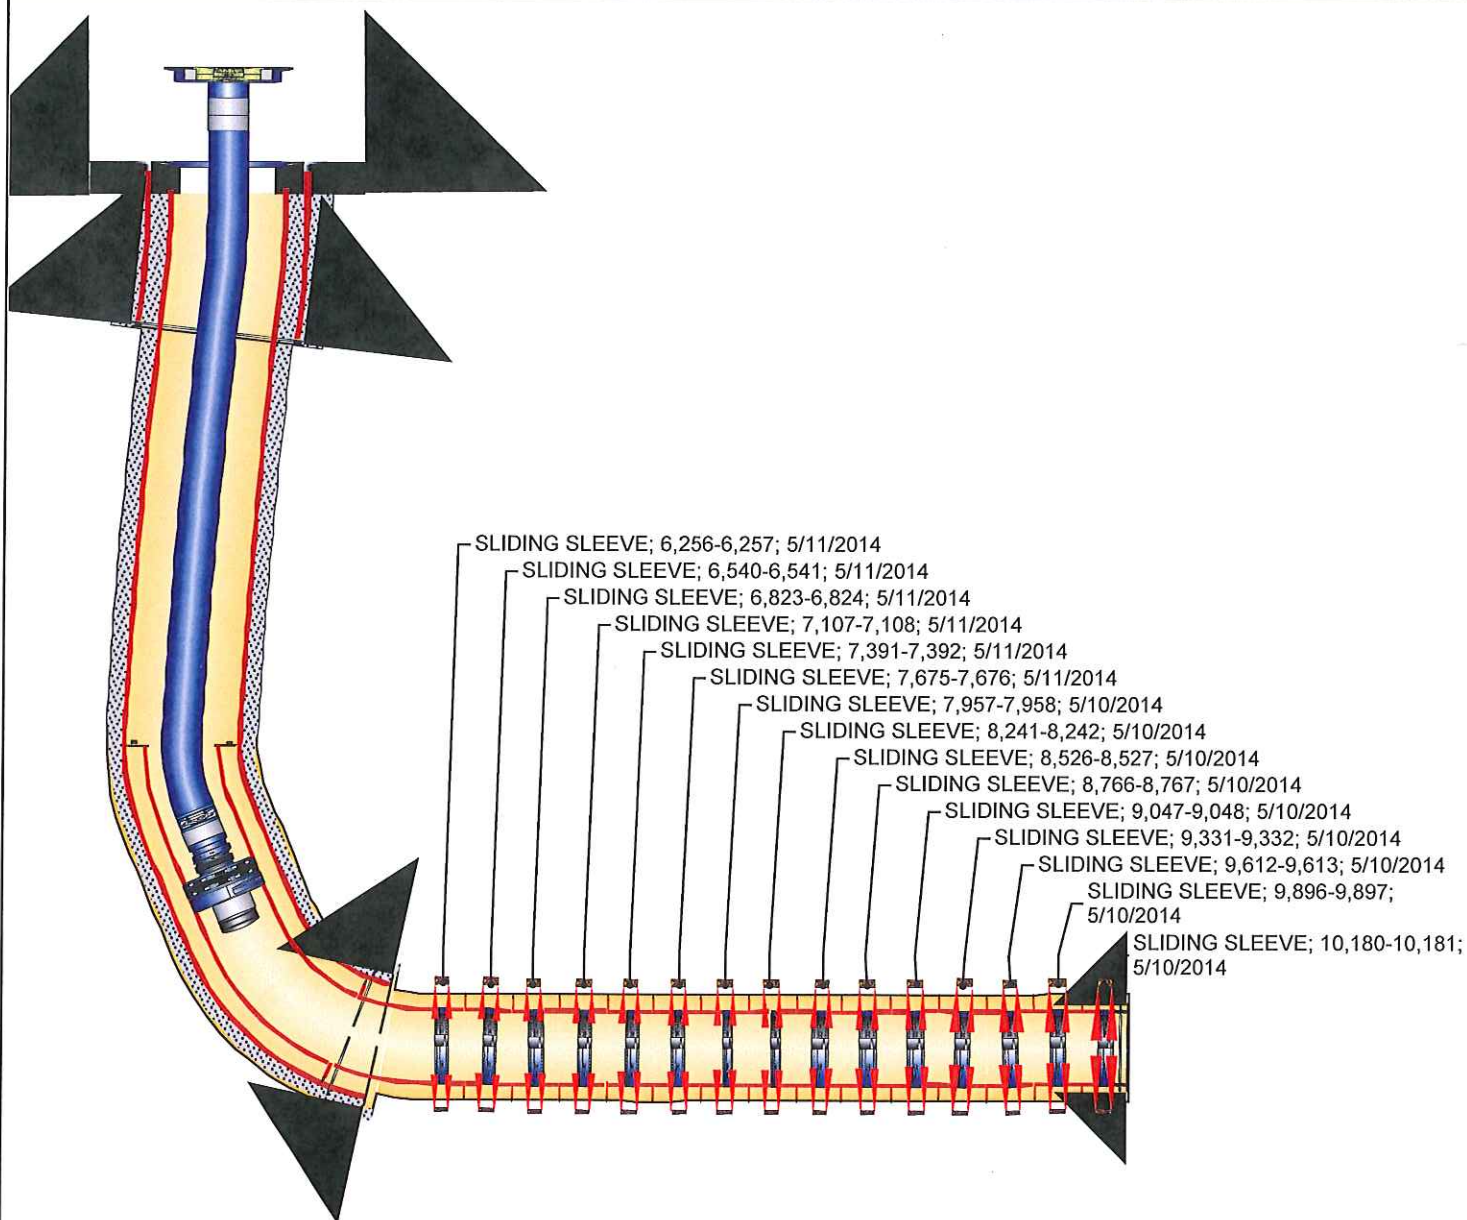


**Well Name: Bringelson Ranch 9-20-9-58**

API/UWI 05-123-38612	Field Name NIOBRARA SHALE	County WELD	State/Province COLORADO	State Plane (E/W - X) (ft) 3,444,618	State Plane (N/S - Y) (ft) 1,514,516
Spud Date 2/20/2014 19:00	Date TD Reached 2/28/2014 08:30	Rig Release Date 3/2/2014 12:00	Original KB Elevation (ft) 4,945	Ground Elevation (ft) 4,928	Total Depth (All) (ftKB)

**HORIZONTAL - ORIGINAL HOLE, 9/9/2014 2:37:57 PM**
**Directional schematic (actual)**


Csg Des	Set Depth (ftKB)	OD (in)	Wt (lb/ft)	Grade	Top Thread
LINER	10,278	5	11.60	P-110	LT&C