OPERATOR:	LEASE / WELL:	SURVEY LOCATION:	DATE
SG Interests	Falcon Seaboard 11-90-12 #5	**Sec 12 T11S R90W**	**10/26/2015**
DRILLING RIG:	COUNTY / STATE:	SURFACE LOCATION:	FIELD:
AZTEC 777	**Gunnison County, CO.**	**1,837' FSL & 1846' FWL**	**Bull Mountain Unit**
20/40			

HORIZONTAL HOLE

DRILLING / COMPLETION FLUID

DRILLING FLUID:	ppg -
DRILLING FLUID:	ppg -
DRILLING FLUID:	ppg -
COMPLETION FLUID:	ppg -
PACKER FLUID:	ppg -

TUBULAR DATA

Tubulars	Size	Weight	Grade	Thread	MD	TVD	TOL
DRIVE PIPE							
CONDUCTOR	20"	106.5#	X-42 / A-53	Welded	80'	80'	
SURFACE	13-3/8"	54.5#	J-55	ST&C	575'	575'	
INTERMEDIATE	9-5/8"	40#	J-55	LT&C	5,503'	5,503'	
PRODUCTION	5-1/2"	20#	HCP-110	CDC-HTQ			
PRODUCTION							
PROD LINER							
PROD TIEBACK							
PROD LINER							
TUBING (Short String)							
TUBING (Long String)							
COILED TUBING							

ELEVATIONS:
RKB:
RKB-ELEV: **17.50**
GROUND ELEVATION

WELLBORE SKETCH

DRAWING NOT TO SCALE

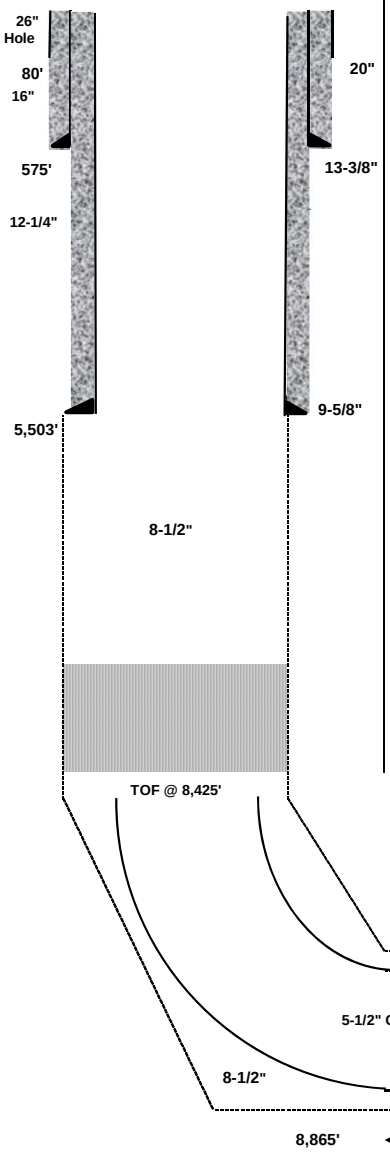

Formation Tops (TVD)	DEPTH MD	INCL DEG	DEPTH TVD
9-5/8" DV Tool @ 3,679'			
CEMENT SIDETRACK PLUG @ 7,754' TO 8,390'			
KOP @ 7,792'			
TOP OF 5-1/2' Csg FISH @ 8,425'			
BOTTOM OF 5-1/2" Csg FISH @ 10,117'			

COMMENTS:
Working Interest:
API # 05-051-06139-00
Net Revenue Interest:
Property#
Spud Date: 8/27/2015

PLUG BACK DEPTH:	**7,550'**	**7,550'**
TOTAL WELL DEPTH:	**13,870'**	**92.34** **8,282'**

PREPARED OR REVISED BY: Dennis Romero
DATE: October 26, 2015

PRESENT PLUGGED ORIGINAL HOLE WBD (NOT TO SCALE)