


Non-Cropland



**Figure 2**  
**Bluffs White**  
**W-62N66W/5NWNE**  
**Site Map**

**Legend**

- Sample Location (9/30 & 10/5/2015)
- Sample Location (10/7-10/8/2015)
- Sample Location (10/9/2015)
- Sample Location (10/12-10/14/2015)
- Former Berm
- Existing Berm
- Excavation Extent

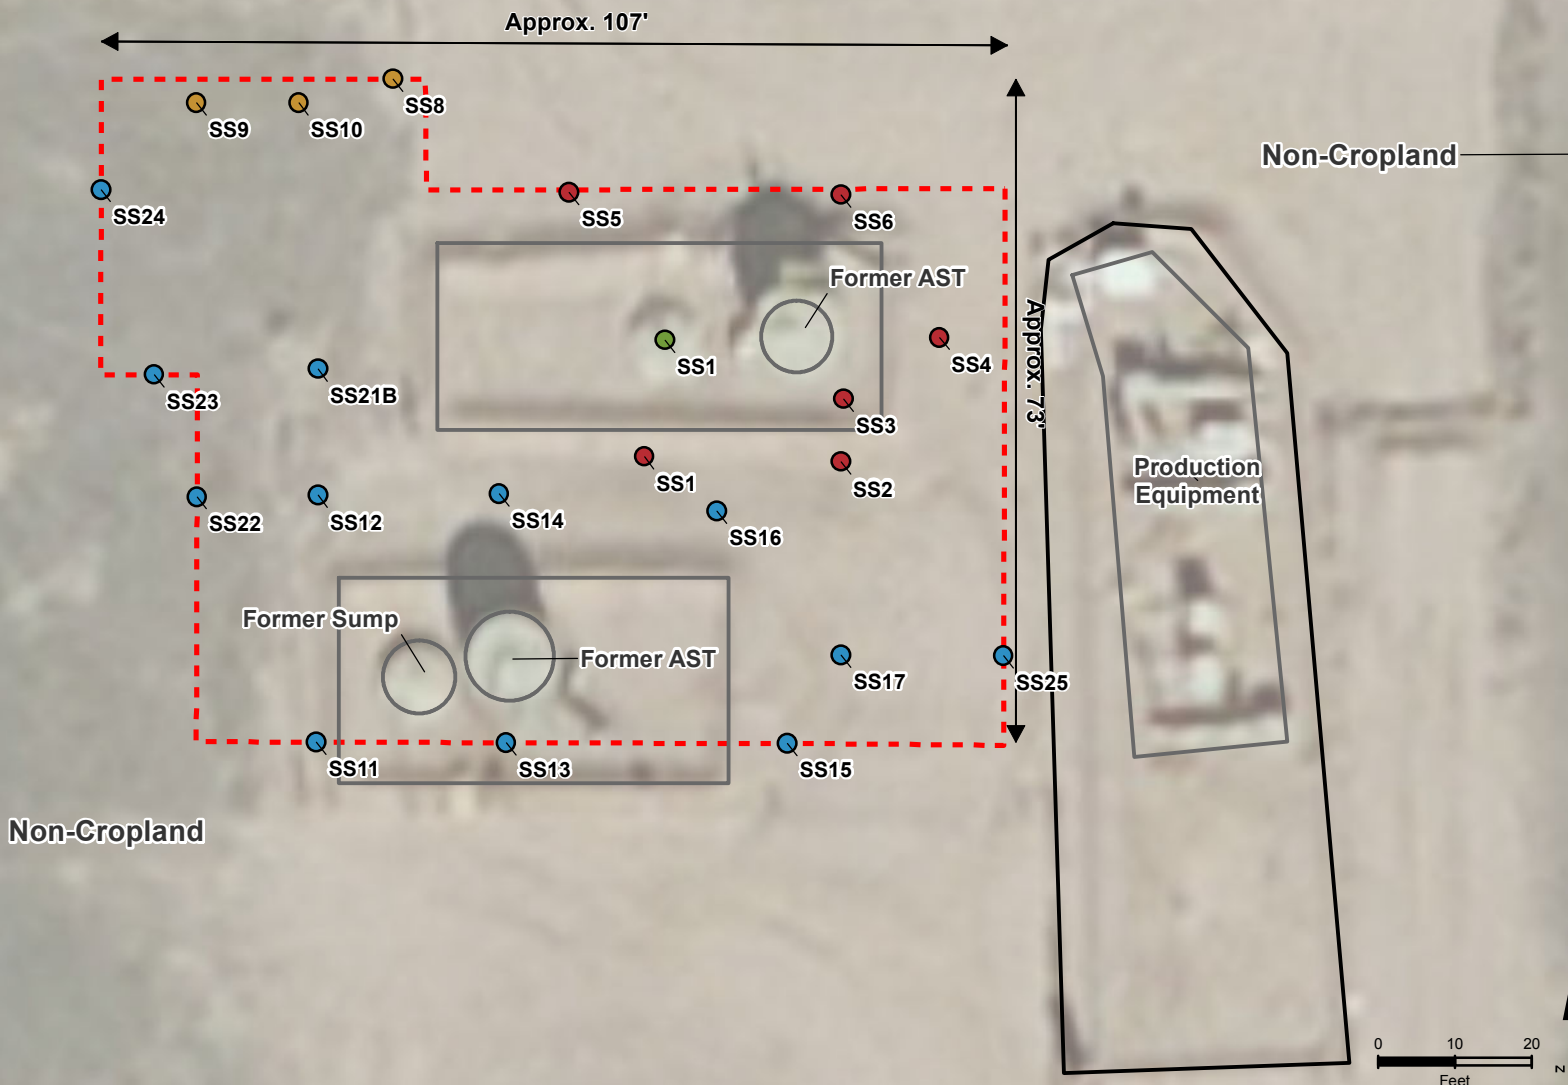

**Site Characteristics**

**Legal Location:** NWNE, Sec 5, T2N R66W  
**County:** Weld  
**Land Use:** Non-Cropland  
**Topography:** 3-9% Slopes  
**Run-Off Risk:** Medium  
**Excavation Area:** ~7,811 Sq-ft  
**Soil Type:** Renohill clay loam  
**Receiving Waters:** Platteville Ditch,  
 1,250-ft Northwest of pad

REVISED	BY	COMMENT
10/15/2015	BJB	Figure 2