

City and County of Denver

Date: 10/30/2015
 Prepared by: JMB
 Well Name: DIA 35-31
 Field: Wattenberg
 Legal: NESW Sec. 35 T2S R65W


Geological tops

Niobrara 7,343'
 Codell 7,728'
 J Sand 8,151'
 Dakota 8,298'

County: Denver
 State: Colorado
 GL: 5,350'
 KB: 5,366'
 API: 05-031-08857

Spud date: 7/20/2007
 Completion date: 7/29/2008
 Producing zone: Dakota

Hole Size 12 1/4"
 Surface Casing 8 5/8" 24#

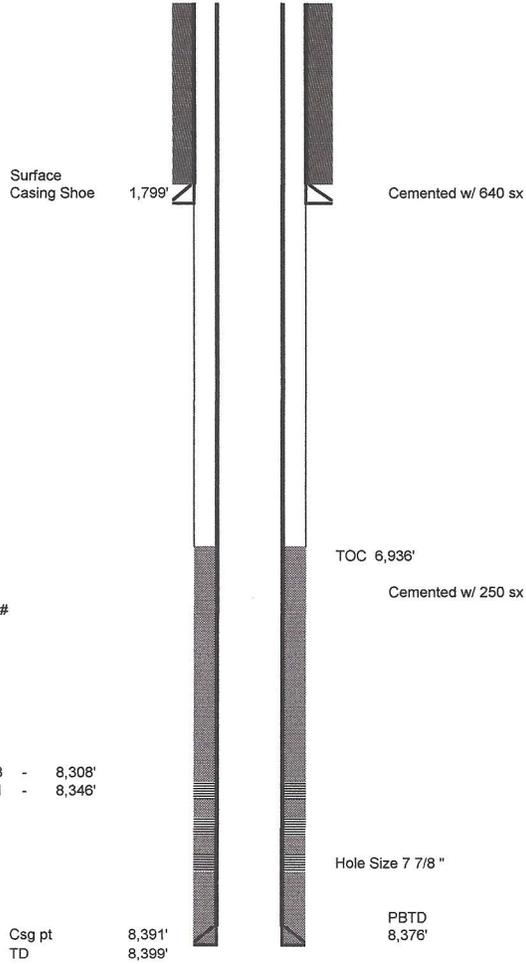

City and County of Denver

Date: 10/30/2015
 Prepared by: JMB
 Well Name: DIA 35-31
 Field: Wattenberg
 Legal: NESW Sec. 35 T2S R65W


Geological tops

Niobrara 7,343'
 Codell 7,728'
 J Sand 8,151'
 Dakota 8,298'

County: Denver
 State: Colorado
 GL: 5,350'
 KB: 5,366'
 API: 05-031-08857

Spud date: 7/20/2007
 Completion date: 7/29/2008
 Producing zone: Dakota

Hole Size 12 1/4"
 Surface Casing 8 5/8" 24#

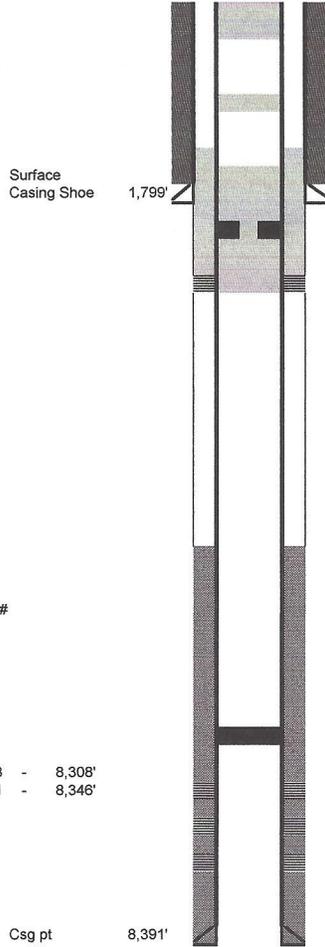

15 sx at surface
 10 sx plug from 600 to 700'
 Cemented w/ 640 sx
 perf 2 shots @ 1,900'
 set ret @ 1,850', pump 100 sx thru
 retainer and 10 sx on top to surface

Production Casing 4 1/2 11.6#

TOC 6,936'
 Cemented w/ 250 sx

Perforations
 Dakota 8,298 - 8,308'
 8,321 - 8,346'

CIBP 8,270' w/ 2 sx See Superior field ticket

Hole Size 7 7/8 "

Csg pt 8,391'
 TD 8,399'

PBD 8,376'

