







WPX Energy Rocky Mountain, LLC  
GV 28-06S-096W  
GM 323-28 Pad  
GM 322-28  
14-10-155  
Final Surveys - Feb.10, 2015



REFERENCE INFORMATION  
Magnetic Declination - 9.97°  
Magnetic Dip Angle - 65.62°  
Field Strength - 51897  
KB Elevation - KELLY BUSHING @ 5500.00usft (H&P 318 (24' RKB) mab)  
Ground Level - 5476.00  
Well Center Northing - 1614784.80  
Well Center Easting - 2262141.80  
Calculation Method - Minimum Curvature  
Geodetic System - US State Plane 1983  
Geodetic Datum - North American Datum 1983  
Map Zone - Colorado Central Zone

WELLBORE TARGET DETAILS

Name	TVD	+N/-S	+E/-W
W/C GM 333-28	0.00	-47.63	58.70
W/C GM 342-28	0.00	-28.69	35.44
W/C GM 422-28	0.00	-4.73	5.84
W/C GM 42-28	0.00	-19.22	23.76
W/C GM 432-28	0.00	-23.76	29.40
W/C GM 433-28	0.00	-50.68	46.58
W/C GM 522-28	0.00	-9.47	11.68
W/C GM 533-28	0.00	-55.42	52.42
W/C GM 542-28	0.00	-42.90	52.86
W/H GM 323-28	10.00	-27.01	17.49
W/H GM 423-28	16.00	-17.35	5.40
W/H GM 523-28	16.00	-7.79	-6.28

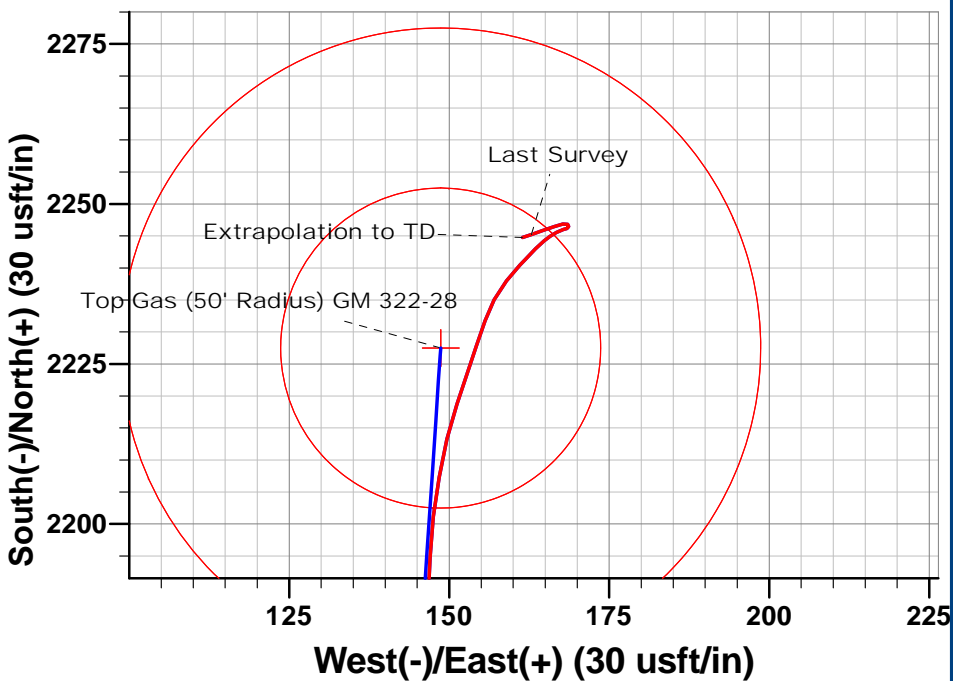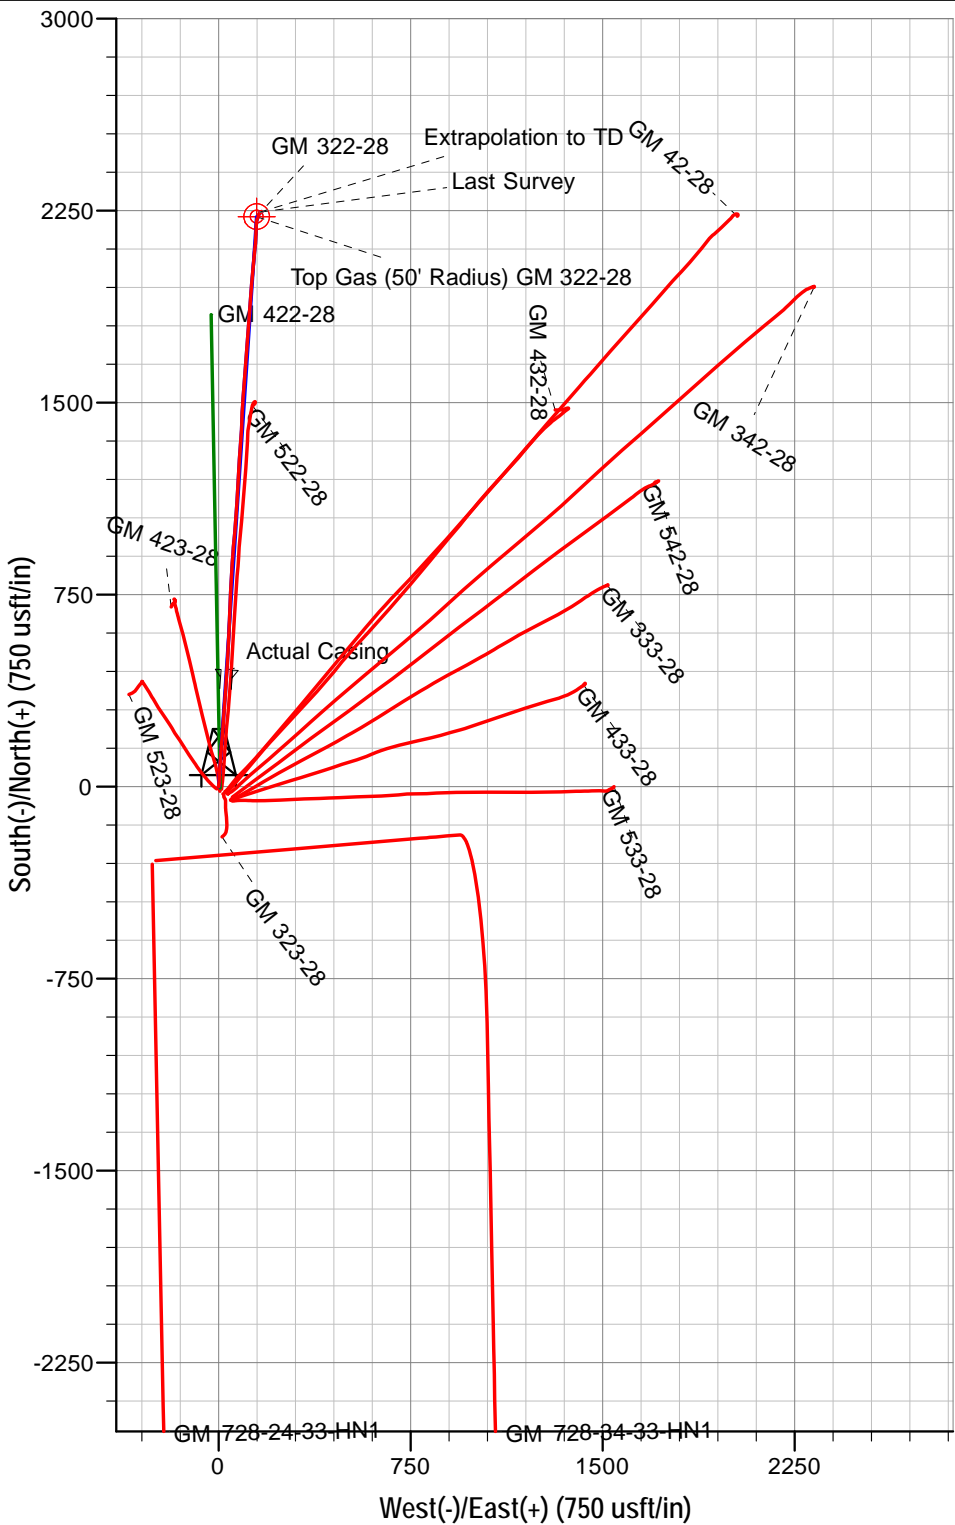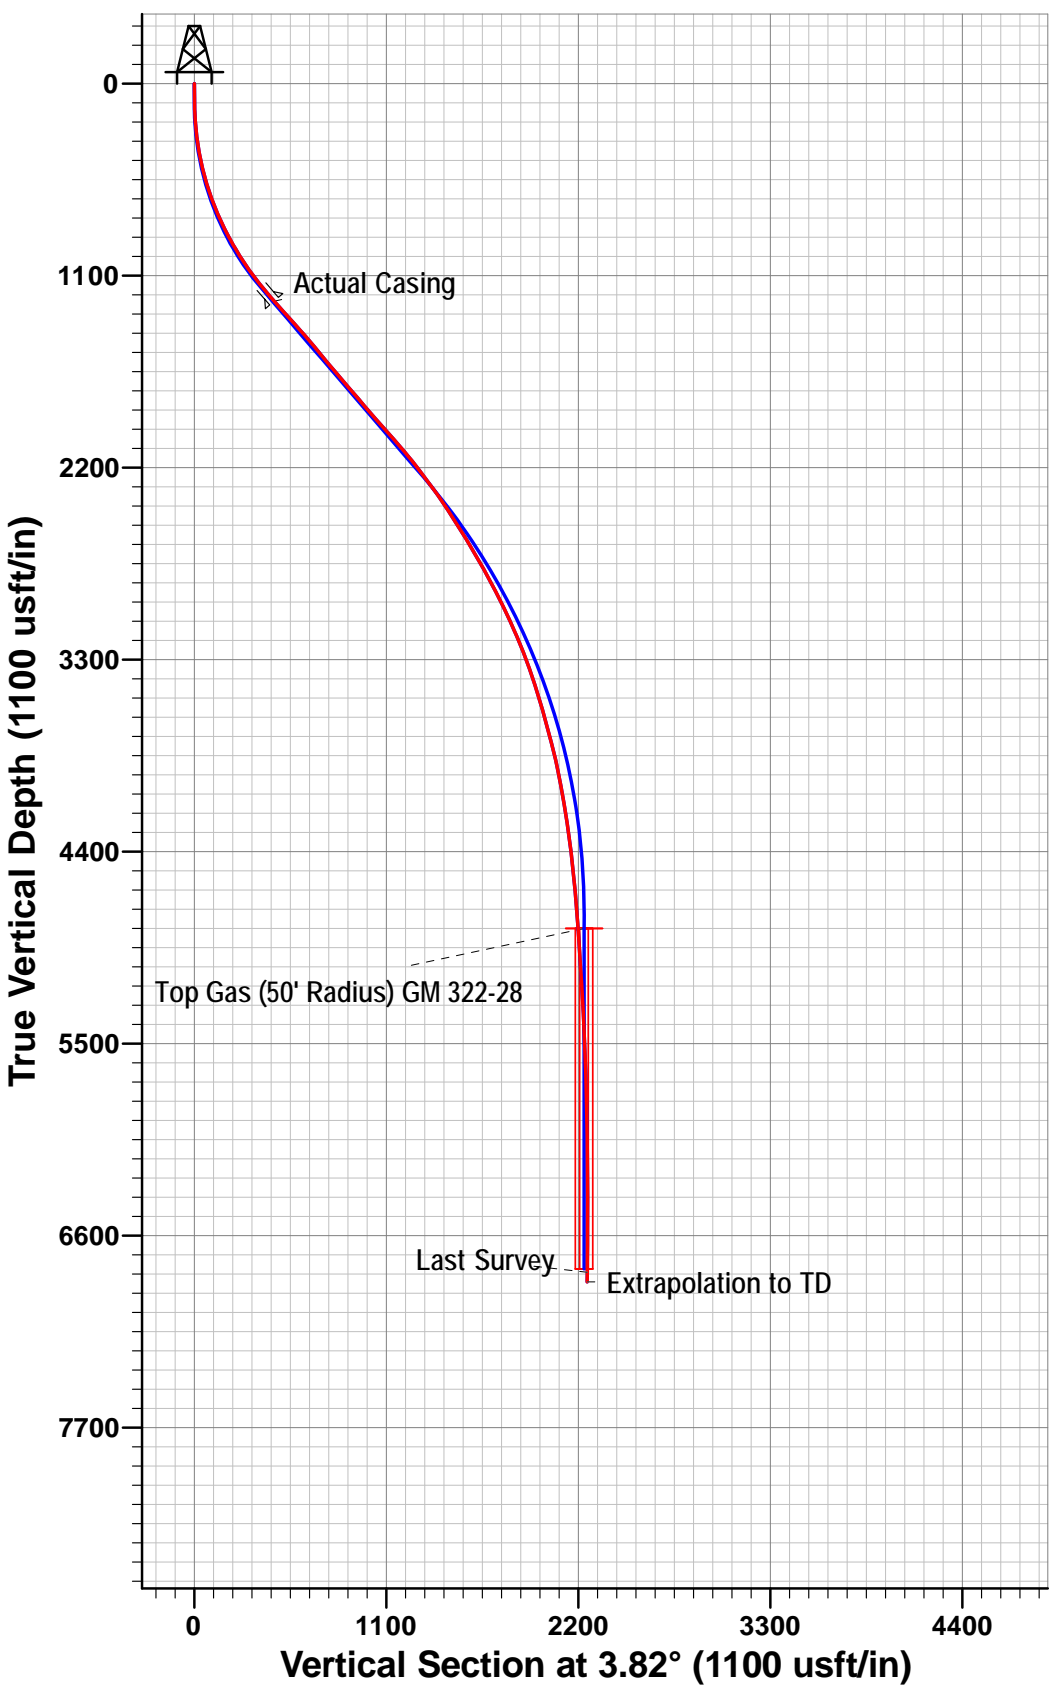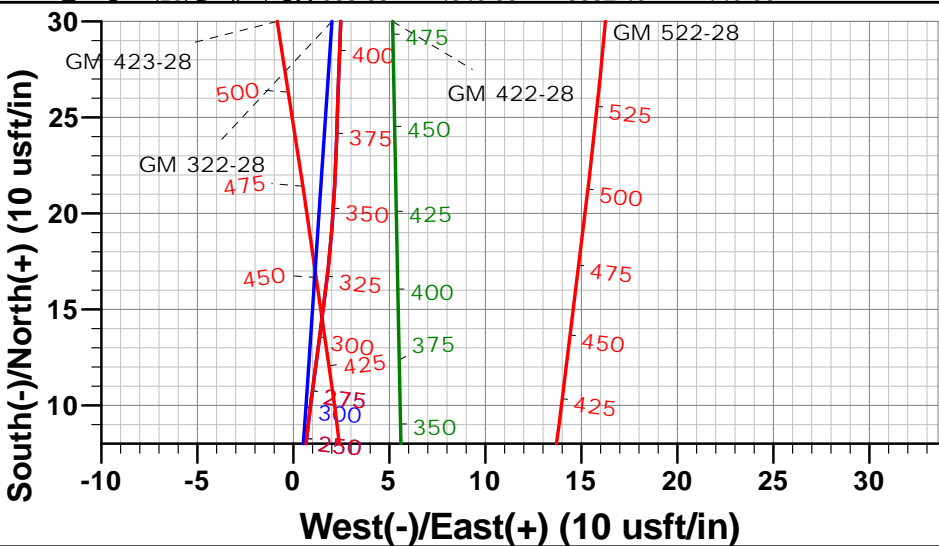

CASING DETAILS

TVD	MD	Name
1245.78	1362.00	Actual Casing

Survey: Final Surveys - Feb 10 2015 (GM 322-28/14-10-155)

Created By: B Varcoe Date: 7:35, February 10 2015