API:	**05-123-21604**	**KB ELEVATION:**	**4769'**	**QTR-QTR:**	**SESE**
WELL NAME:	**PSC 16-4**	**GROUND LEVEL:**	**4757'**	**SECTION:**	**4**
COUNTY:	**WELD**	**MD:**	**7282'**	**TWNSHIP:**	**3N**
LATITUDE:	**40.24941**	**PBMD:**	**7282'**	**RANGE:**	**67W**
LONGITUDE:	**-104.88897**	**CREATED BY:**	**MICHAEL LEE**		
		DATE:	11/2/2015		
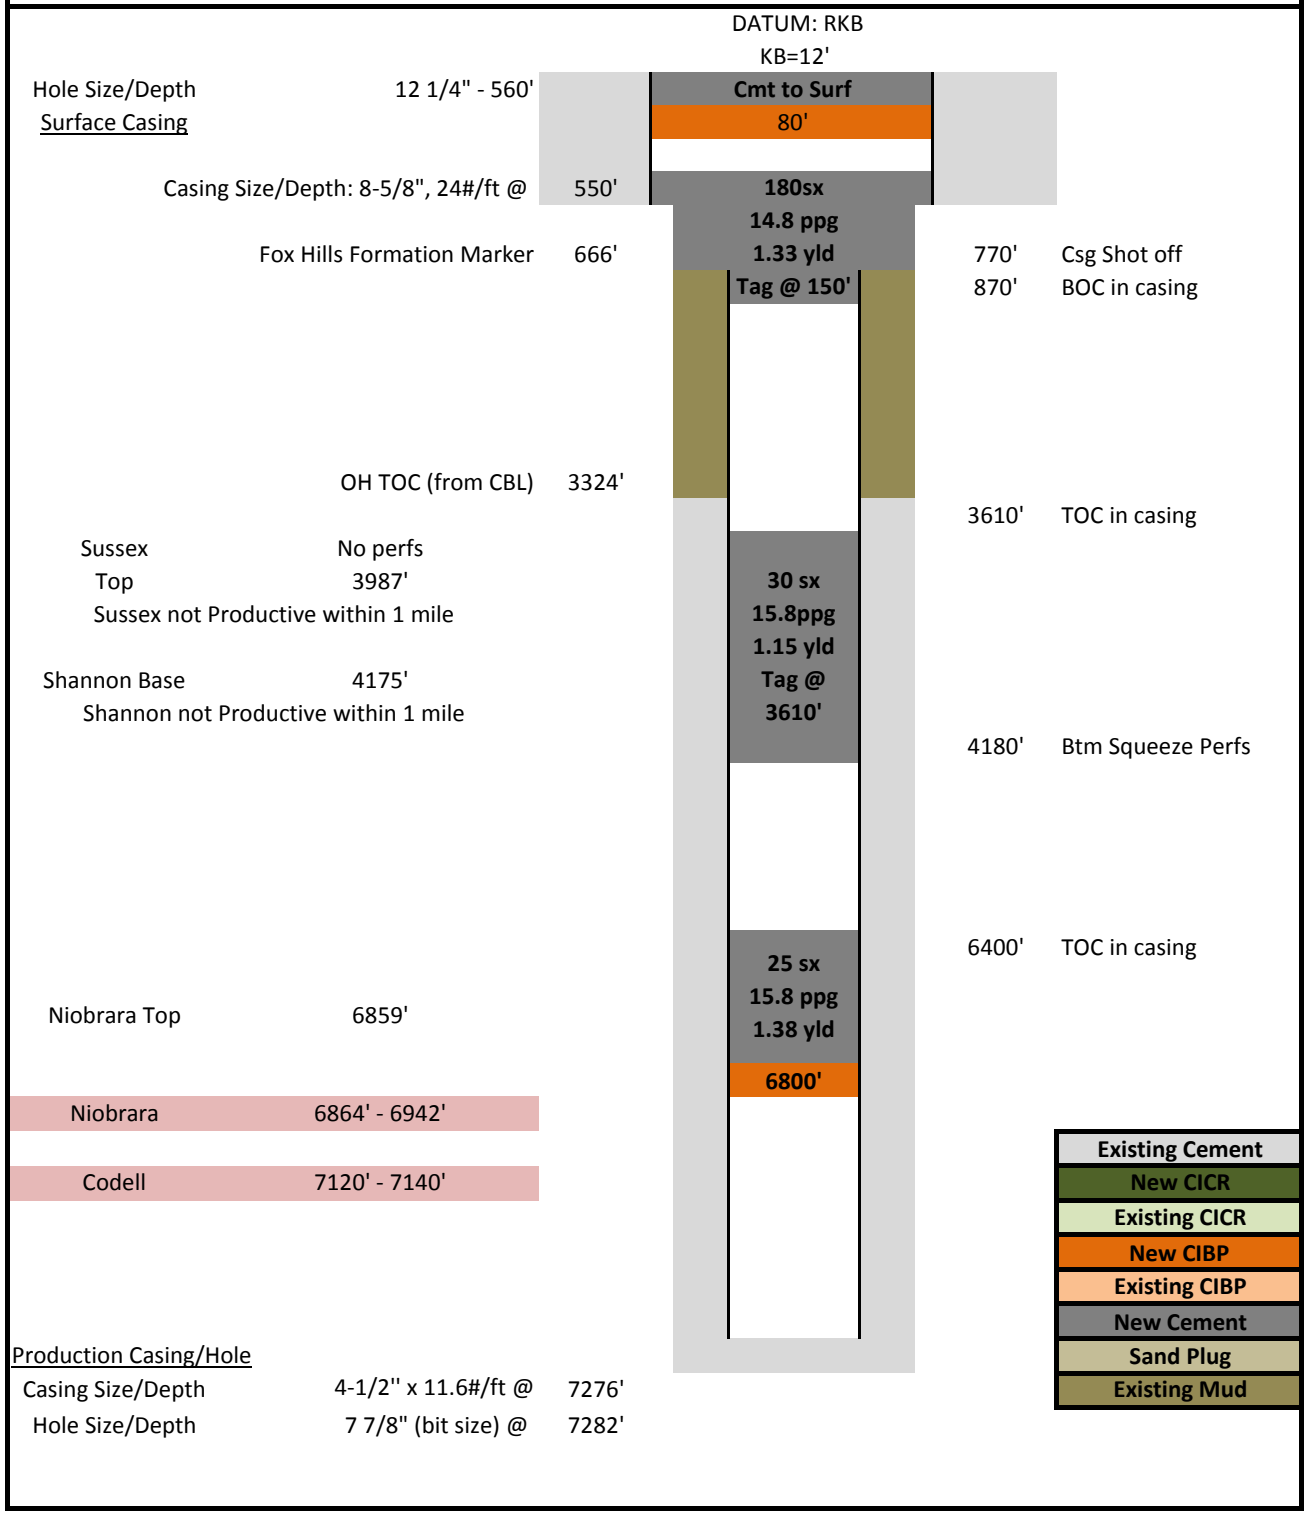
FINAL