

LEGEND

- X RELEASE LOCATION
- SOIL SAMPLE
- ⊗ EXISTING MONITORING WELL (REMEDATION #1617)
- ⊕ FORMER RECOVERY CULVERT (REMEDATION #1617)
- GROUNDWATER SAMPLE
- M FORMER METER HOUSE
- x — x FORMER FENCE
- EXCAVATION EXTENT
- FORMER BERM

GROUNDWATER SAMPLE ID
 B: BENZENE CONCENTRATION
 RESULTS IN MICROGRAMS PER LITER
BOLD INDICATES RESULT EXCEEDS STANDARD

IMAGE COURTESY OF GOOGLE EARTH 2014

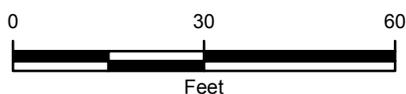


FIGURE 2
 EXCAVATION SITE MAP
 HSR-REDMOND-63N67W/21NWSW
 NWSW SEC 21-T3N-R67W
 WELD COUNTY, COLORADO
 KERR-MCGEE OIL & GAS ONSHORE LP

