


Skaer #3 Tank Battery Separator Closure Form 19 Site Map

Legend

- Soil Sample Location
- Excavation Extent
- Former Separator

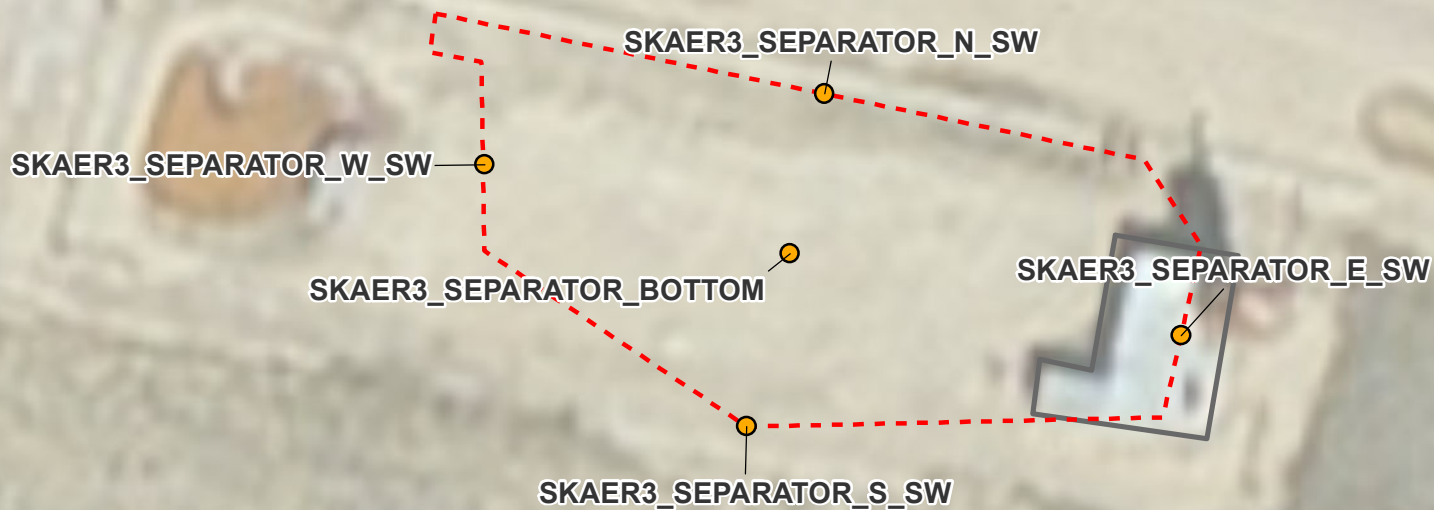

Site Characteristics

Legal Location: SESE, Sec 25, T5N R69W
County: Larimer
Land Use: Agricultural
Topography: 5-9% Slopes
Run-Off Risk: Low
Excavation Area: ~2,240 Sq-ft
Soil Type: Otero sandy loam
Receiving Waters: Big Thompson Ditch Number 2,
 970-ft North of pad

REVISED	BY	COMMENT
10/19/2015	BJB	Figure 1