


#### NOTES:

- ALL BEARINGS ARE GRID BASED UPON THE COLORADO STATE PLANE COORDINATE SYSTEM, NORTH ZONE, NAD83(2011) DERIVED FROM POST-PROCESSED STATIC GPS OBSERVATIONS.
- DISTANCES ARE ON GRID
- VERTICAL DATUM IS NAVD88 BASED UPON GPS OBSERVATIONS
- PDOP VALUE EQUALS 1.3.
- GPS OPERATOR: JOHN STODDARD.
- UNDISTURBED GROUND ELEVATION AT WELLHEAD = 4596.8'
- ALL SECTION LENGTHS ARE MEASURED DISTANCES UNLESS NOTED BY (R), RECORD BEARING AND DISTANCE.
- NEAREST CULTURAL DISTANCES
  - BUILDINGS: 1740' +/-
  - BUILDING UNIT: 1740' +/-
  - HIGH OCCUPANCY BUILDING UNIT: 5280'+
  - DESIGNATED OUTSIDE ACTIVITY AREA: 5280'+
  - PUBLIC ROAD: 5280'+
  - ABOVE GROUND UTILITY: 1654' +/-
  - RAILROAD: 5280'+
  - PROPERTY LINE: 4734' +/-


5	NAD 83		STATE PLANE COORDINATES	
Y-U-13HC	LATITUDE	LONGITUDE	NORTHING	EASTING
SURFACE	40.39365	104.37684	1388228.01	3312833.99
TARGET 1	40.39329	104.37513	1388102.19	3313309.71
TOP	40.39356	104.37514	1388202.13	3313306.44
BOTTOM HOLE	40.40536	104.37545	1392497.23	3313166.21

#### CERTIFICATE OF SURVEYOR:

I, DAVID A. FEHRINGER OF LANDER, WYOMING HEREBY CERTIFY THAT THIS WELL LOCATION CERTIFICATE WAS PREPARED FROM NOTES TAKEN DURING AN ACTUAL SURVEY ON DECEMBER 17, 2014; AND THAT IT CORRECTLY SHOWS THE DRILLING LOCATION OF BONANZA CREEK ENERGY, INC., NORTH PLATTE Y-U-13HC AS STAKED DURING SAID SURVEY. THIS MAP DOES NOT REPRESENT A BOUNDARY SURVEY OR AN IMPROVEMENT LOCATION PLAT AND SHOULD NOT BE USED FOR THE ESTABLISHMENT OF BOUNDARY LINES.

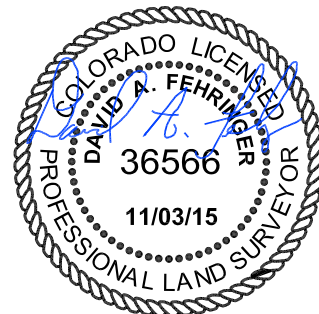

Drawn By: MAM  
 Checked By: DAF  
 Date: 12-22-2014  
 Revision: 2  
 Date: 11-03-15  
 Explanation:  
 CULTURAL  
 DISTANCES

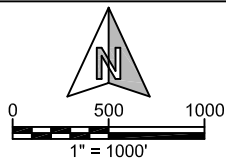

#### WELL LOCATION CERTIFICATE

NORTH PLATTE Y-U-13HC  
 SE $\frac{1}{4}$ , SECTION 13,  
 T.5N., R.63W., 6th PM  
 WELD COUNTY, COLORADO



410 17TH STREET  
 DENVER, CO 80202  
 (720) 440-6100

SHEET

1

OF

1