


McCallum Unit #145
2460' FSL & 2395' FEL (NW SE) Sec 2-T9N-R79W
Jackson County, Colorado
API # 05-057-06386

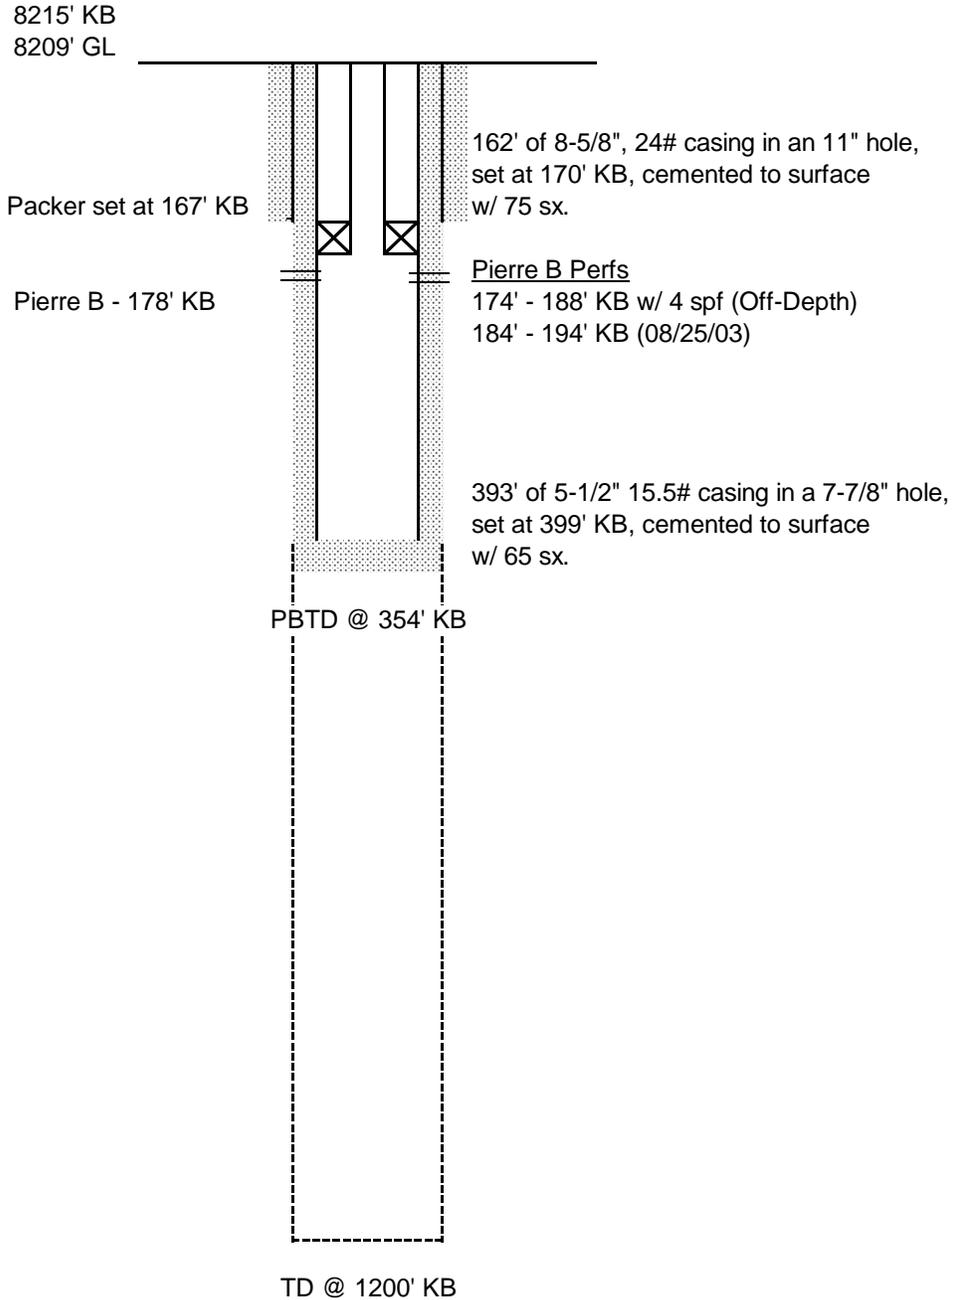

Updated September 11, 2003 trz