

Morrison Development, LLC
Drilling - Completion - Workover - Facilities
WELLBORE DIAGRAM After P&A

Well / Battery	Prospect Name	Total Depth	Est. Start Date
Morrison Investment #1		8,090'	
Location	Sec-Twn-Rng	Producing Horizon	County & State
SWSW	1 T1S R68W		Adams County, Colorado

WELLBORE DIAGRAM

Cementing Information

25 sxs annular plug from 100' to surf


21 sxs casing plug from 325' to surf

Perforated at 265' NO injection rate

20 sxs casing plug at 890 TOC: 714"
Tagged cement at 890'

CIBP set at 7,450'
with 2 sxs on top

TD: 8,100
 PBTD: 8,090'

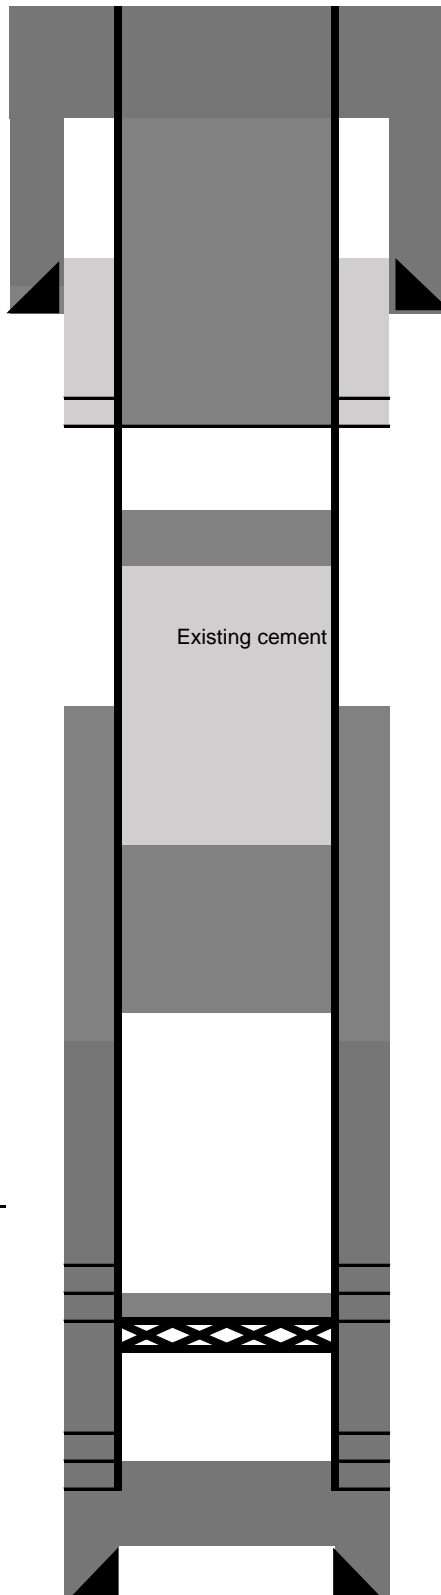

Surface Casing

8 5/8" 24# set at 215' TOC at surface

215' surface casing shoe

COGCC annotation
 DV Tool from original completion 250 sx
 CBL - 1026' - 380'

Calculated TOC from orig. completion (250 sx 6715')

TOC: 4,773' (Calc.)

Perforations at 7,500'-7,524'
 7,918', 7,940'

Perforations at 8,058-63'

Production Casing

5-1/2" 17# set at 8,090'
 500 sxs (between primary and stage)

