


WELLBORE DIAGRAM
 EXTRACTION OIL & GAS
 GRANT BROTHERS 43-23
 NESE SEC 23 T2N R68W
 WELD COUNTY
 05-123-07814

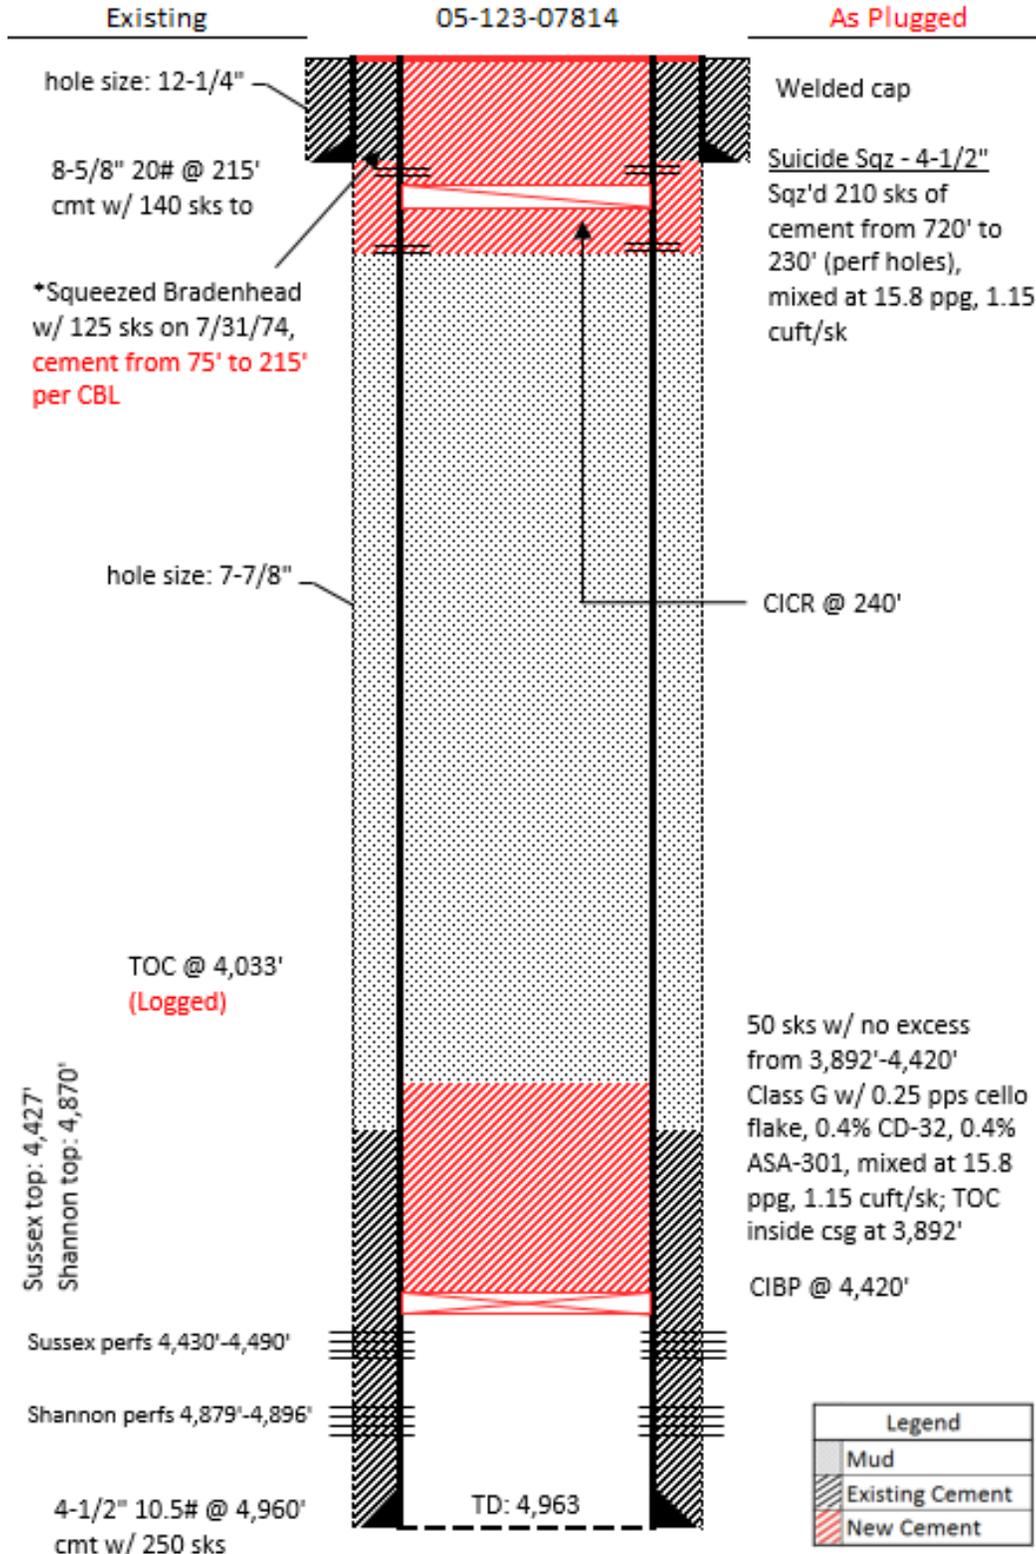

Legend	
	Mud
	Existing Cement
	New Cement