


WELL NAME	API	OPERATOR	KB (ft)	GL (ft)	SURF LAT	SURF LON	SPUD	LOCATION	COUNTY	STATE
Spicer 03-32H	05-057-06469	EE3 LLC (10450)	8,246'	8,225'	40.528361	-106.404461	6/3/14	SWSW S32 T7N R80W	Jackson	CO

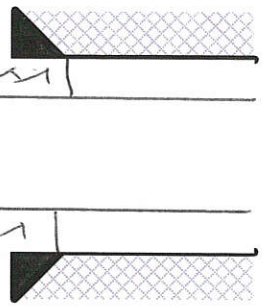

Hole Size	13-1/2"
Casing	9-5/8" – 36# – K55 – @ 1,400' – (6/6/14)
Cement	940 sx – 197 bbls – yield 1.18 – 15.2 ppg – (6/7/14)

Cement Plug @ 3,114'
240 sx – Class G


KOP(2) @ 6,555'

KOP(1) @ 6,783'

Hole Size	8-3/4" – (7/6/14)
Casing	5-1/2" – 23# – P110 – @ 11,187' – (7/10/14)
Lead Cement	700 sx – 299 bbls – yield 2.4 – 11.3 ppg
Tail Cement	1,200 sx – 356 bbls – yield 1.67 – 13.8 ppg – (7/11/14)

22 stage frac - (7,570' – 11,002')
3,826,225 lb of 20/40
68,851 barrels of fluid - (8/12/14)

End of Casing
MD: 11,002'
TVD: 7,326'

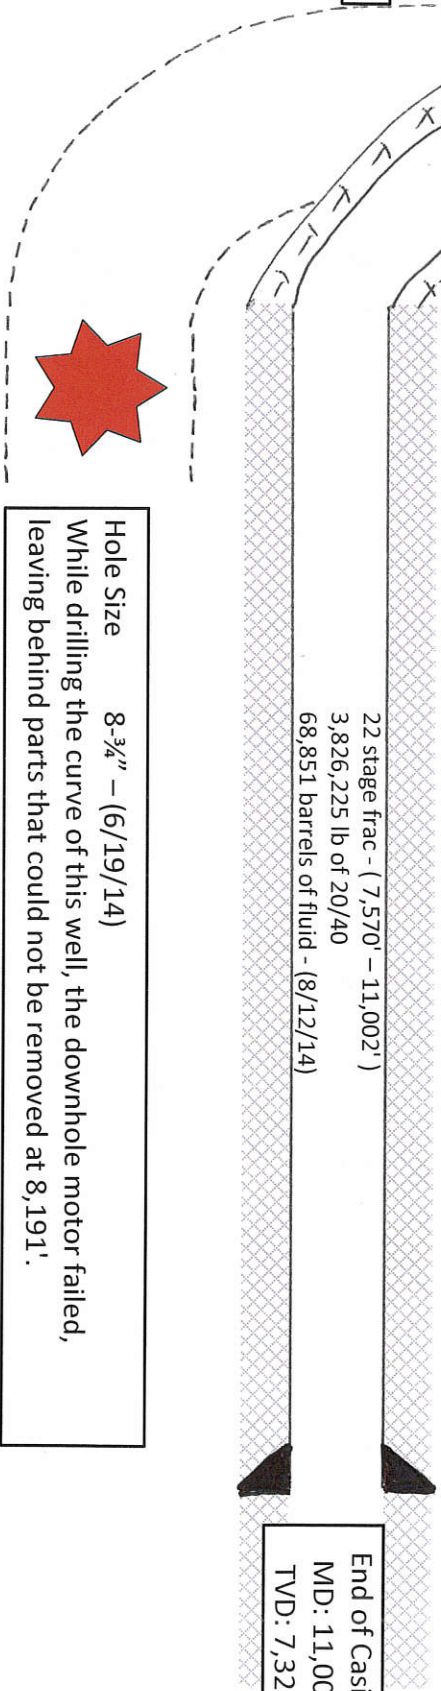

Hole Size 8-3/4" – (6/19/14)
While drilling the curve of this well, the downhole motor failed, leaving behind parts that could not be removed at 8,191'.

