

Well : WOOLLEY 12-7
Field : Wattenberg
County : Weld County **State** : Colorado
Surface : Lat: 40.0672305 Long: -105.0532037
: 2117 FNL, 457 FWL SWNW Sec 7 T1N R68W
API # : 05-123-22988
Grd Elev : 4991' GR **KB Elevation:** 5007' KB

Log Tops:

Fox Hills Base 337'
 Sussex 4440'
 Niobrara 7374'
 Codell 7736'
 J Sand 8164'

Surface Casing

8-5/8" 24# Surface Casing
 set @ 815', cmt'd w/ 570
 sx

Stage Cmt 3950'-5400'
 w/ 305 sx
 CBL dated 08/25/15


TOC @ 6300'
 Cmt'd w/ 250 sx
 CBL 08/25/15

Production Casing

4-1/2" 11.6# J-55 production casing
 set @ 8321'. Cmt w/ 250 sx

Production Tubing

2-3/8" J-55 4.7# Tubing 261
 jts. set @ 8154'
 (10/04/05)

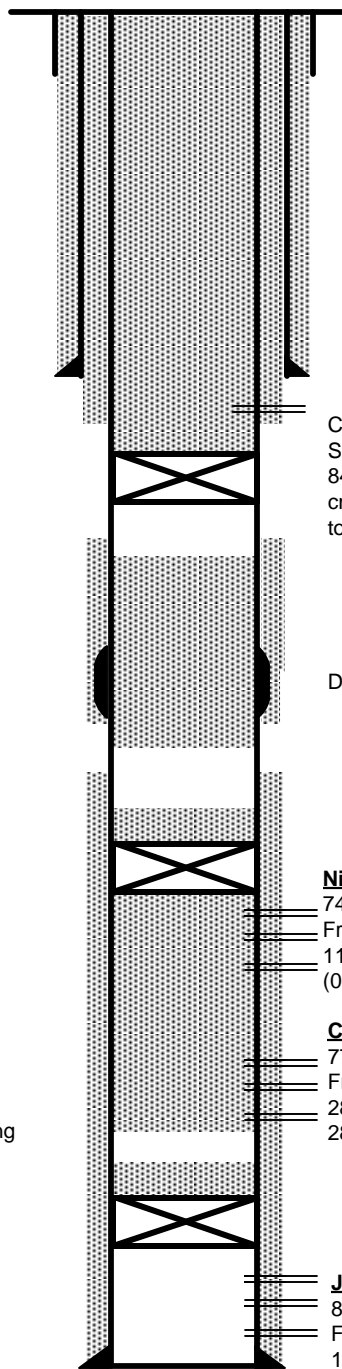

TD 8325'

Well History:

Spud	05/28/05
TD	06/03/05
P&A	08/27/15

Drawn by:

Tyler Barela

Date:

06/10/15