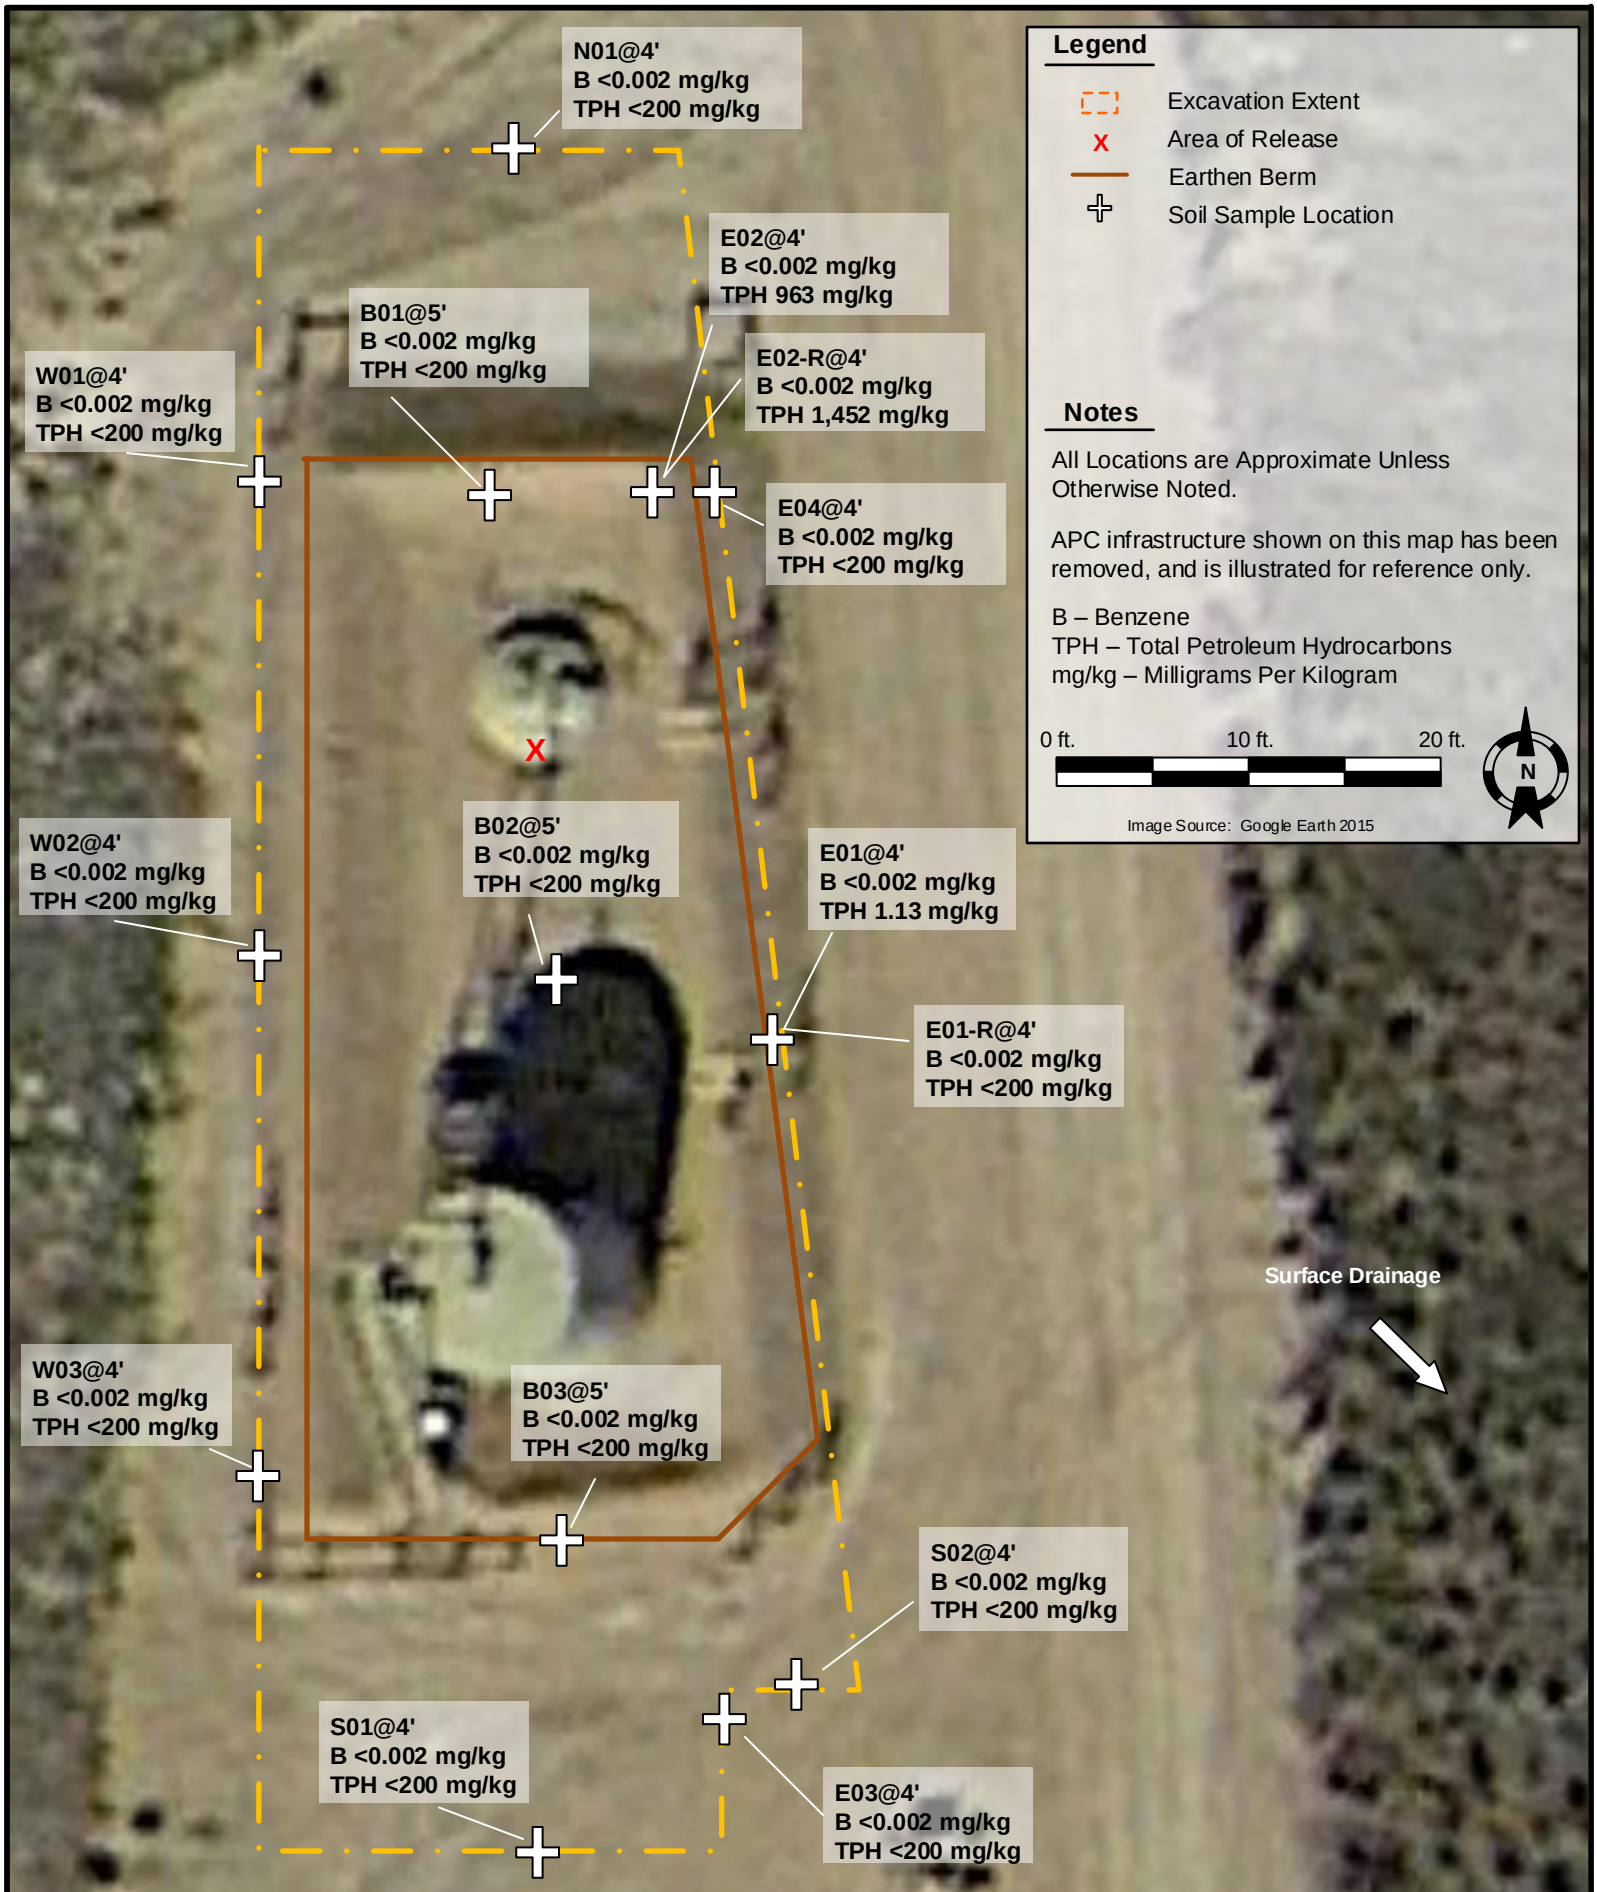

DESIGNED BY: BRN DRAWN BY: BRN DATE: 9/8/2015	TASMAN GEOSCIENCES	**Kerr-McGee Oil and Gas Onshore, LP** **UPRR 43 Pan Am 0#2** NENW, Section 13, Township 1 North, Range 68 West Weld County, Colorado

FIGURE 2
Sample Location Map