



# INVOICE

PLEASE REMIT PAYMENT TO: PEAK WELL SERVICE, LLC - PO BOX 643 ROOSEVELT, UTAH 84066  
PHONE 435-722-1282 - FAX 435-722-1283

INVOICE DATE	INVOICE #
11/19/2015	A-29-2-96-N

WELL NAME	DUE DATE	TERMS
A-29-2-96-N	12/19/2015	Net 30

Ordered By	PROJECT	RIG #	P.O. NO.
JOHN CLA...		1900	

BILL TO
KOCH EXPLORATIO COMPANY LLC 4111 EAST 37TH STREET NORTH WICHITA, KANSAS 67220

Item	Service Date	Service Ticket #	Description	Quantity	Rate	Amount
P&A SERVICES	11/19/2015	A-29-2-96-N	P&A SERVICES MIRU, NU WH, NU BOPS TALLY AND TIH W/ 4 5/8 BIT AND 2 3/8 TBG TAG TOF AT 6093'. TOOH W/ TBG LD BIT PU 5 1/2" BICP TIH W/ TBG SET TOOL AT 6080', SPOT 15 SKS ON TOP, ATTEMPT TO PRESSURE TEST 5 1/2 CSG FAIL. TOC 5946 TOOH W/ TBG, PU 5 1/2 PKR TIH W/ PKR FIND HOLES AT 4500, TIH W. 5 1/2 CICR AND TBG SET TOOL AT 4345' PUMP 215 SKS BELOW CICR STING OUT SPOT 15 SKS ON TOP, TOC 4211'. TOOH W/ TBG RU WIRELINE, PERFORATE AT 2127, TOOH W/ WIRELINE, PU 5 1/2 CICR TIH W/ TBG SET CICR AT 2045 ATTEMPT TO PUMP DOWN CICR CIRCULATE UP TO 9 5/8 SURFACE. FAIL. PUMP 40 SKS BELOW 5 1/2 CICR STING O UT SPOT 15 SKS ON TOP TOC. TOOH W/ TBG ND BOP'S DIG AND CUT WELLHEAD TIH W/ 1" BETWEEN 5 1/2 AND 9 5/8 TO 100' PUMP 20 SKS TO FILL TO SURFACE. TH W/ 1" IN 5 1/2 TO 100 ' PUMP 40 FILL CASING TO SURFACE RDMOL.	1	34,000.00	34,000.00
CEMENT	11/19/2015	A-29-2-96-N	CEMENT PER SACK Out-of-state sale, exempt from sales tax	150	22.00 0.00%	3,300.00 0.00
				Total		
				\$37,300.00		

150 Extra STS  
cement at \$22


\$ 3300

+

\$ 34000

to fail

37300 ✓

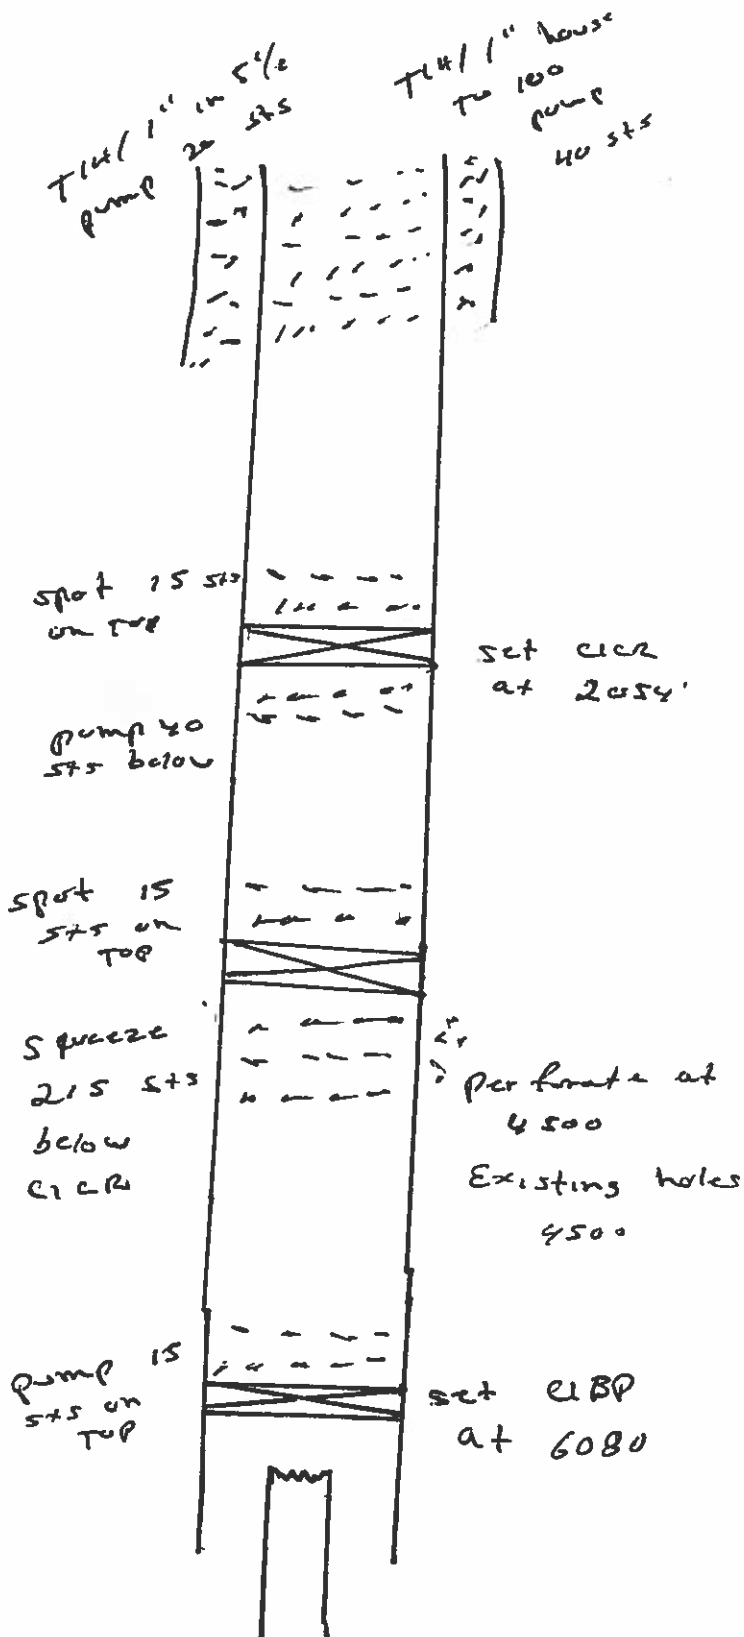

M1 Rig up NU WH NU BOP'S Tally an T14  
w/ 4 5/8 bit and 2 3/8 Tubing TAs TOF at 6093  
T04 / tubing laid down bit pu 5 1/2 C18P T14

Tubing set tool at 6080 spot 15 sts on top  
Attemp to pressure test 5 1/2 CSG Fail  
T0C 5946 T04 / Tubing pu 5 1/2 packer T14 / Packer

Find holes at 4500' T04 / tubing Rv wire line

Perforate at 4500 T14 / w 5 1/2 C18K and tubing

set tool at 4345' Pump 215 sts below C18K

stings out spot 15 sts on top T0C 41211

T04 / tubing Rig up wire line perforate at

2127 T04 / wL pu 5 1/2 C18K T14 / tubing

set C18K at 2045 Attemp to pump down

C18K circulate up to 95/9 surface Fail

pump 40 sts below 5 1/2 C18K stings out

spot 15 sts on top T0C

T04 / tubing NO BOP'S Rig and cut well head

T14 / 1" between 5 1/2 and 95/9 to 100'

pump 20 sts to fill to surface T14 / 1"

in 5 1/2 to 100' pump 40 fill CSG to surface

Rig down move out