

**Final ABANDONMENT Diagram** (plugged 12-17-2015)

**Hanavan 15-1**

Pronghorn Operating LLC (#10422)


SWSE, Sec. 15-13S-44W 6PM

API #: 05-017-07449

Cheyenne Cty, CO

Casing cut off 4 feet below ground  
level with welded steel plate

8 5/8" 24# @ 422'  
(100 sx Lite+125 sx H)  
TOC @ surface

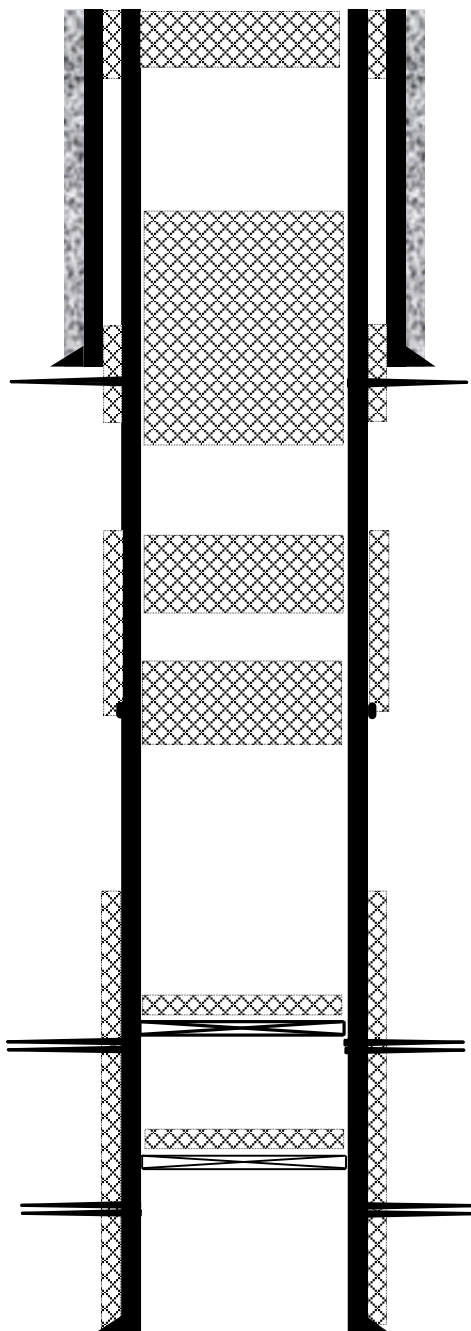

0' - 50'

20 sx in casing, 40 sx in annulus

450-451'

perfs, Squeezed w/ 40 sx (1998 PA)

350' - 600'

40 sx laid

1100' TOC

(Completion Report)

1500' - 1285'

25 sx laid

2583' Stage Tool

(125 SX Lite +100 SX)

2600' - 2385'

25 sx laid

4512' TOC

(CBL\_5-5-2014 )

4800' set CIBP w 2 sx

4815-4819' Perfs

5330' CIBP w 2 sx

5346-5362' Perfs

5.5" casing 15.5# @ 5510'  
cmt w 100 sx