




Lat40°, Inc. 1635 Foxtrail Drive, Suite 325 Loveland, CO 970-776-3321

WELL LOCATION CERTIFICATE

THIS MAP DOES NOT REPRESENT A BOUNDARY SURVEY

SECTION: 35
TOWNSHIP: 9N
RANGE: 59W

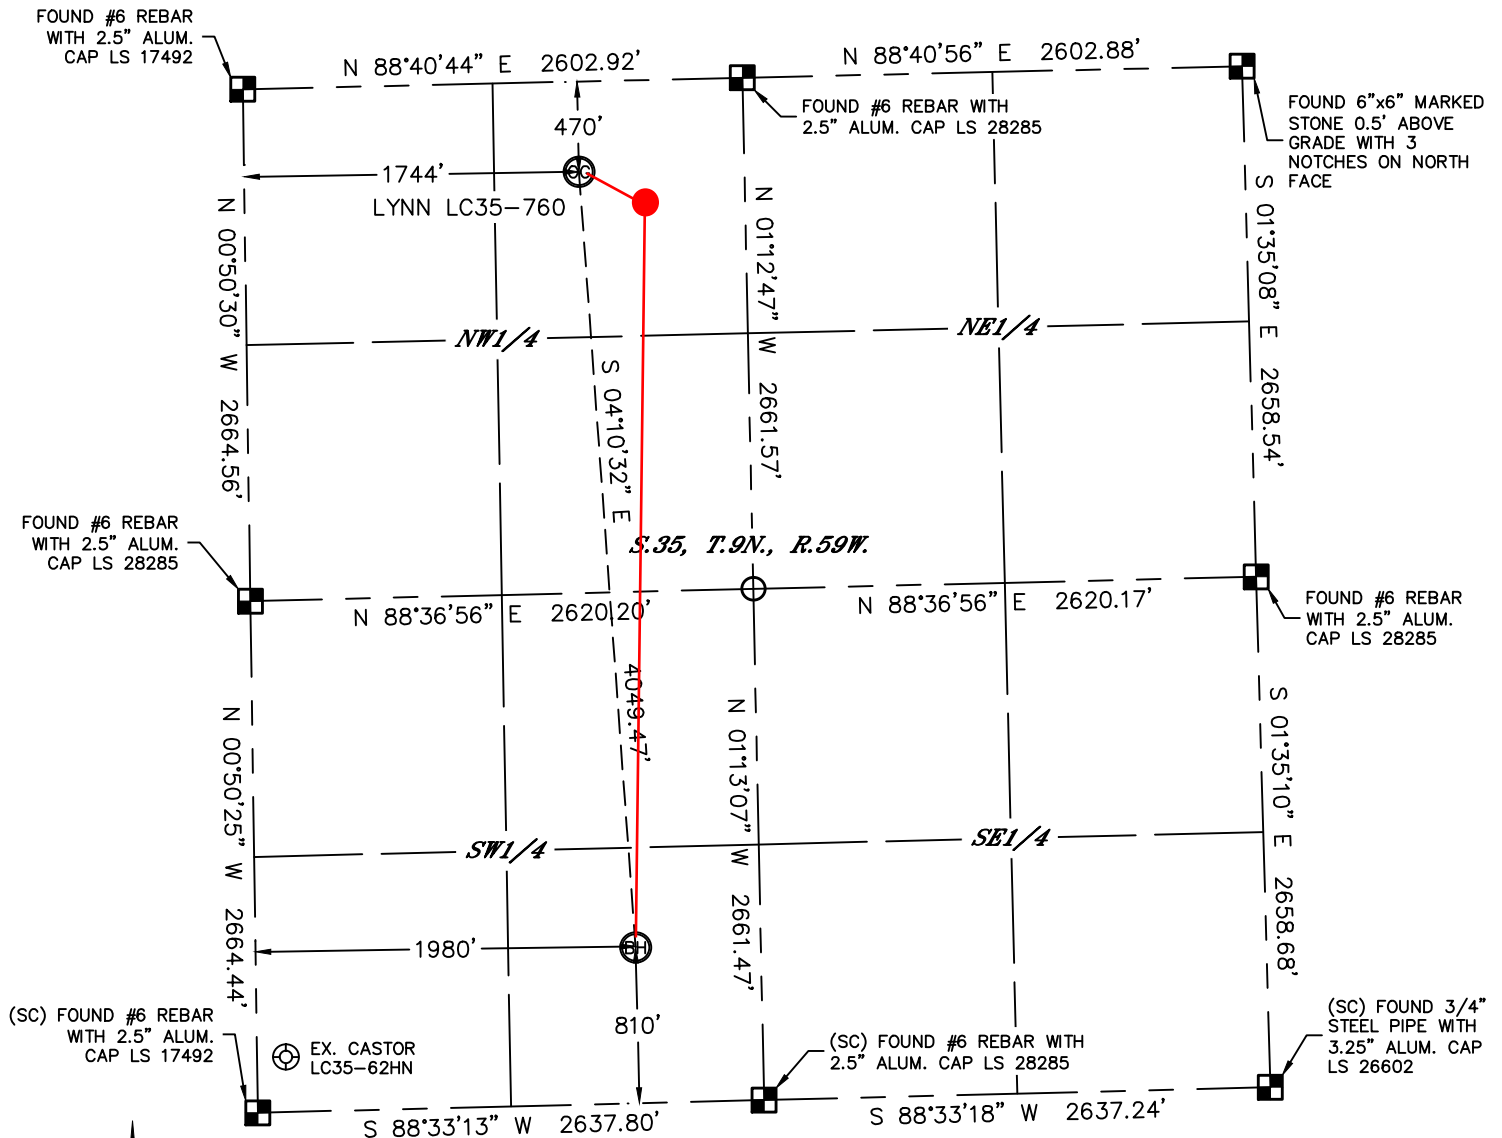

0 1000
1"=1000'

In accordance with a request from Brian James with Noble Energy Inc.

Lat40°, Inc. has determined the surface location of the LYNN LC35-760 to be 470' from the NORTH line and 1744' from the WEST line and the bottom hole to be 810' from the SOUTH line and 1980' from the WEST line as measured at right angles from the section lines of Section 35, Township 9 North, Range 59 West of the Sixth Principal Meridian, County of Weld, State of Colorado.

I hereby state that this Well Location Certificate was prepared by me, or under my direct supervision, that the fieldwork was completed on 4/22/2015, for and on behalf of Noble Energy Inc. That this is not a Land Survey Plat or an Improvement Survey Plat, and that it is not to be relied upon for establishment of fence, building, or other future improvement lines.

NOTE:

- 1) Bearings shown are Grid Bearings of the Colorado State Plane Coordinate System, North Zone, North American Datum 1983/2007. The lineal dimensions as contained herein are based upon the "U.S. Survey Foot."
- 2) Ground elevations are based on an observed GPS elevation (NAVD 1988 DATUM).
- 3) IMPROVEMENTS: See LOCATION DRAWING for all visible improvements within 500' of disturbed area.
- 4) SURFACE USE: RANGELAND
- 5) INSTRUMENT OPERATOR: ADAM BEAUPREZ
- 6) NEAREST EXISTING WELL: CASTOR LC35-62HN, ±4854' SW
- NEAREST CULTURAL ITEMS:
BUILDING: 5280'+
BUILDING UNIT: 5280'+
HIGH OCCUPANCY BUILDING UNIT: 5280'+
DESIGNATED OUTSIDE ACTIVITY AREA: 5280'+
PUBLIC ROAD: 5280'+
ABOVEGROUND UTILITY: ±537' N
RAILROAD: 5280'+
PROPERTY LINE: ±470' N

SURFACE LOCATION

LAT: 40.71304°N
LONG: 103.94795°W
PDOP: 1.7
ELEV: 4814'
1/4,1/4: NE1/4NW1/4

BOTTOM HOLE


LAT: 40.70194°N
LONG: 103.94714°W

TPZ: 590FNL, 2090 FWL

LEGEND

- = ALIQUOT MONUMENT AS DESCRIBED
○ = CALCULATED POSITION

Brian T. Brinkman—On Behalf of Lat40°, Inc.
Colorado Licensed Professional
Land Surveyor No. 38175
DATE: 4/28/2015
PROJECT#: 2013186


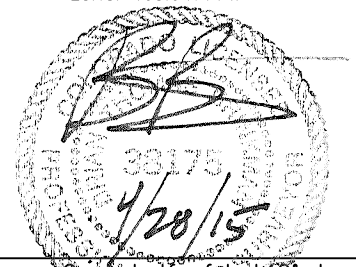




Lat40°, Inc. 1635 Foxtrail Drive, Suite 325 Loveland, CO 970-776-3321

SITE SKETCH
LYNN LC35-760

SECTION: 34
TOWNSHIP: 9N
RANGE: 59W

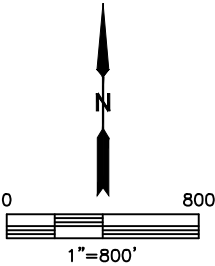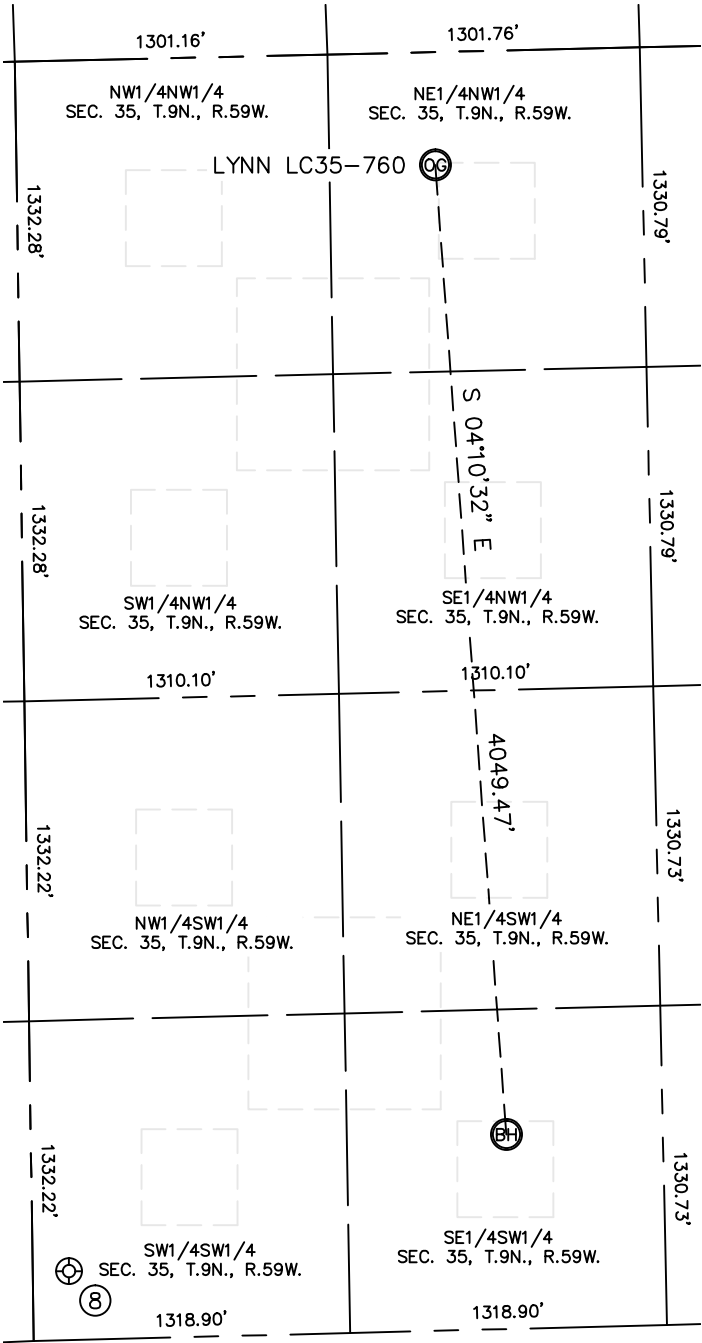

WELL NO.	WELL NAME	SHL FOOTAGE			SHL LAT°	SHL LONG°	PDOP	ELEV (FT.)	1/4/1/4
8	CASTOR LC35-62HN	287	FSL	150 FWL	40.70047	-103.95374	1.9	4838	SWSW