



WPX Energy Rocky Mountain, LLC

RU 07-07S-093W

RU 42-7 Pad

RU 41-7

Final Surveys - Jan.29,2015

REFERENCE INFORMATION

Magnetic Declination - 9.80°

Magnetic Dip Angle - 65.65°

Field Strength - 51881

Geodetic System - US State Plane 1983

Geodetic Datum - North American Datum 1983

Map Zone - Colorado Central Zone

KELLY BUSHING @ 7763.00usft (Nabors 574 (26' RKB) kjs)




Ground Level - 7737.00

Site Northing - 1600591.20

Site Easting - 2348404.40

DESIGN TARGET DETAILS

Name	TVD	+N/-S	+E/-W
RU 32-7_W/C	0.00	-37.49	0.95
RU 331-7_W/C	0.00	-7.50	0.19
RU 332-7_W/C	0.00	-44.99	1.14
RU 341-7_W/C	0.00	0.24	9.60
RU 41-7_W/C	0.00	0.00	0.00
RU 42-7_W/C	0.00	-37.24	10.91
RU 431-7_W/C	0.00	-7.24	10.15
RU 432-7_W/C	0.00	-44.72	11.10
RU 531-7_W/C	0.00	-29.74	0.76
Top Gas (25' Radius) RU 41-7	6918.00	2200.25	-376.43
Top Gas (50' Radius) RU 41-7	6918.00	2200.25	-376.43

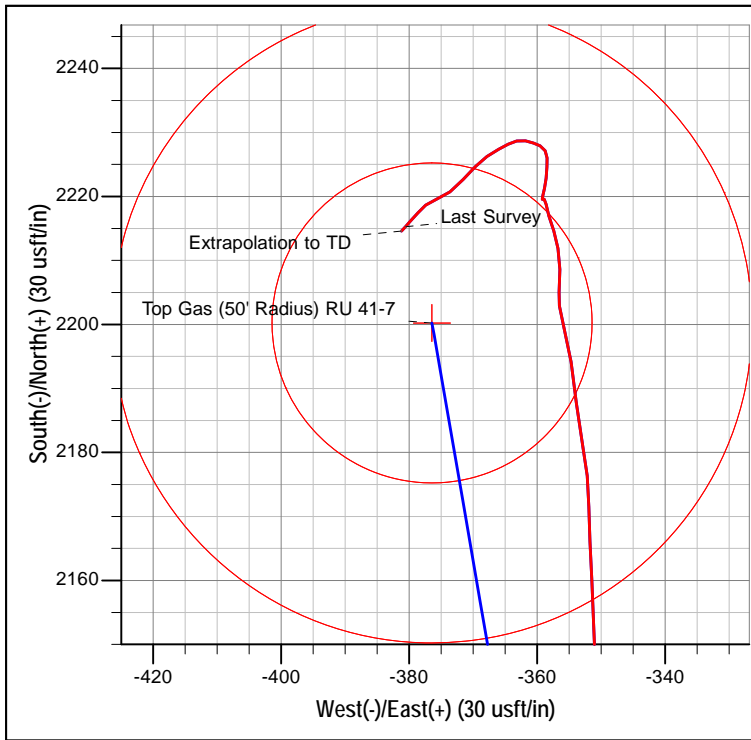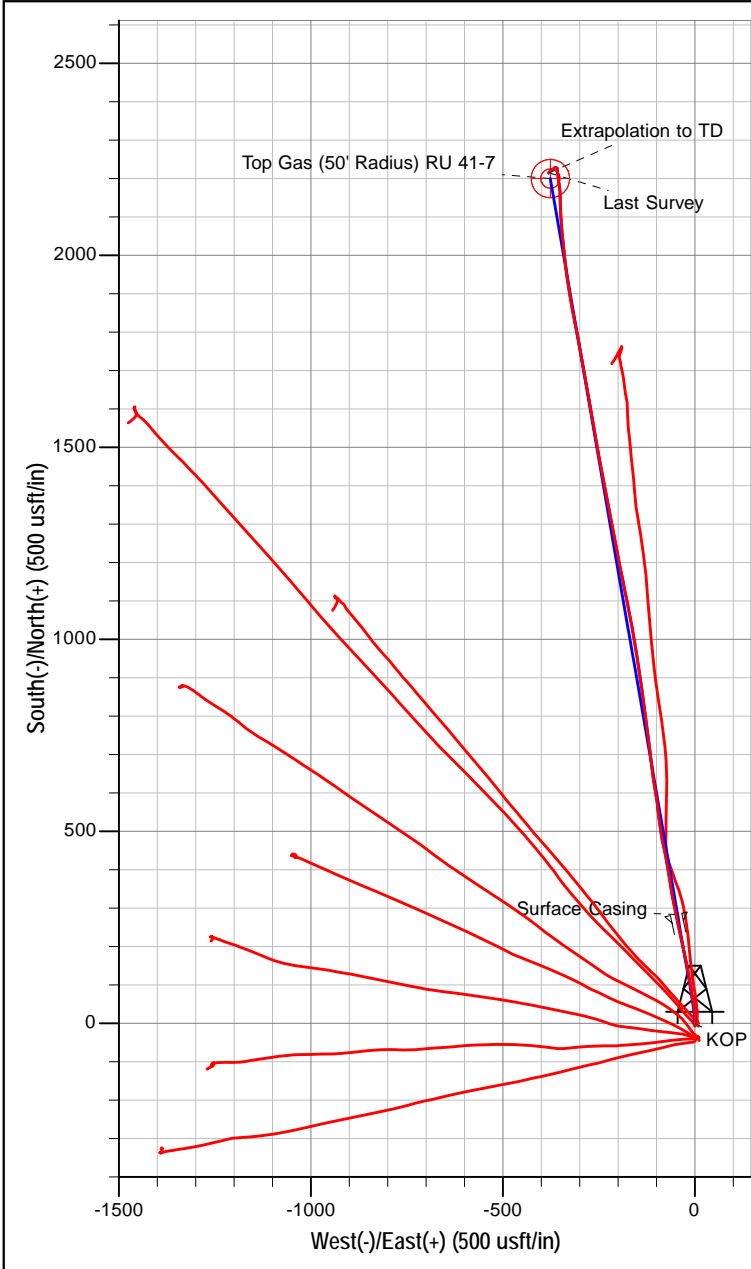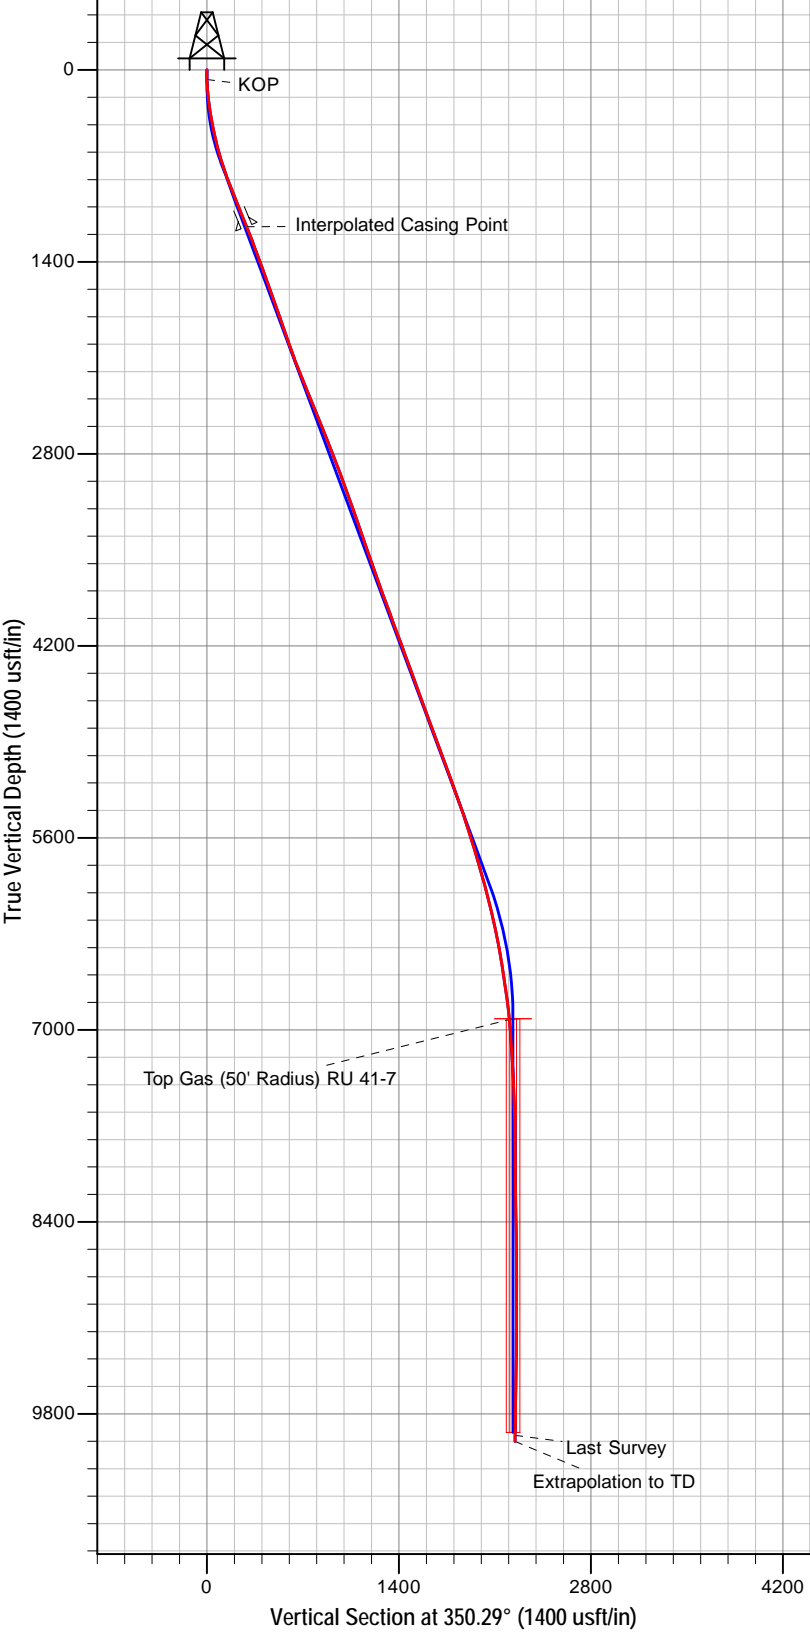

CASING DETAILS

TVD	MD	Name	Size
1143.25	1188.00	Surface Casing	

Survey: Final Surveys (RU 41-7/14-08-125)

Created By: Abby Nieradka Date: 8:03, January 29 2015