Whiting Oil & Gas Corp
1700 Broadway, Suite 2300
Denver, CO 80290
(303) 837-1661

RAZOR FED 30K-1908

Well Name	API Number	County
RAZOR FED 30K-1908	051234021200	Weld

Section	Township	Township N/S Dir	Range	Range E/W Dir	Meridian	Quarter 1	Quarter 2
30	10	N	58	W		NE	SW

Lateral/Horizontal - Original Hole, 1/11/2016 12:05:34 PM

Vertical schematic (actual)

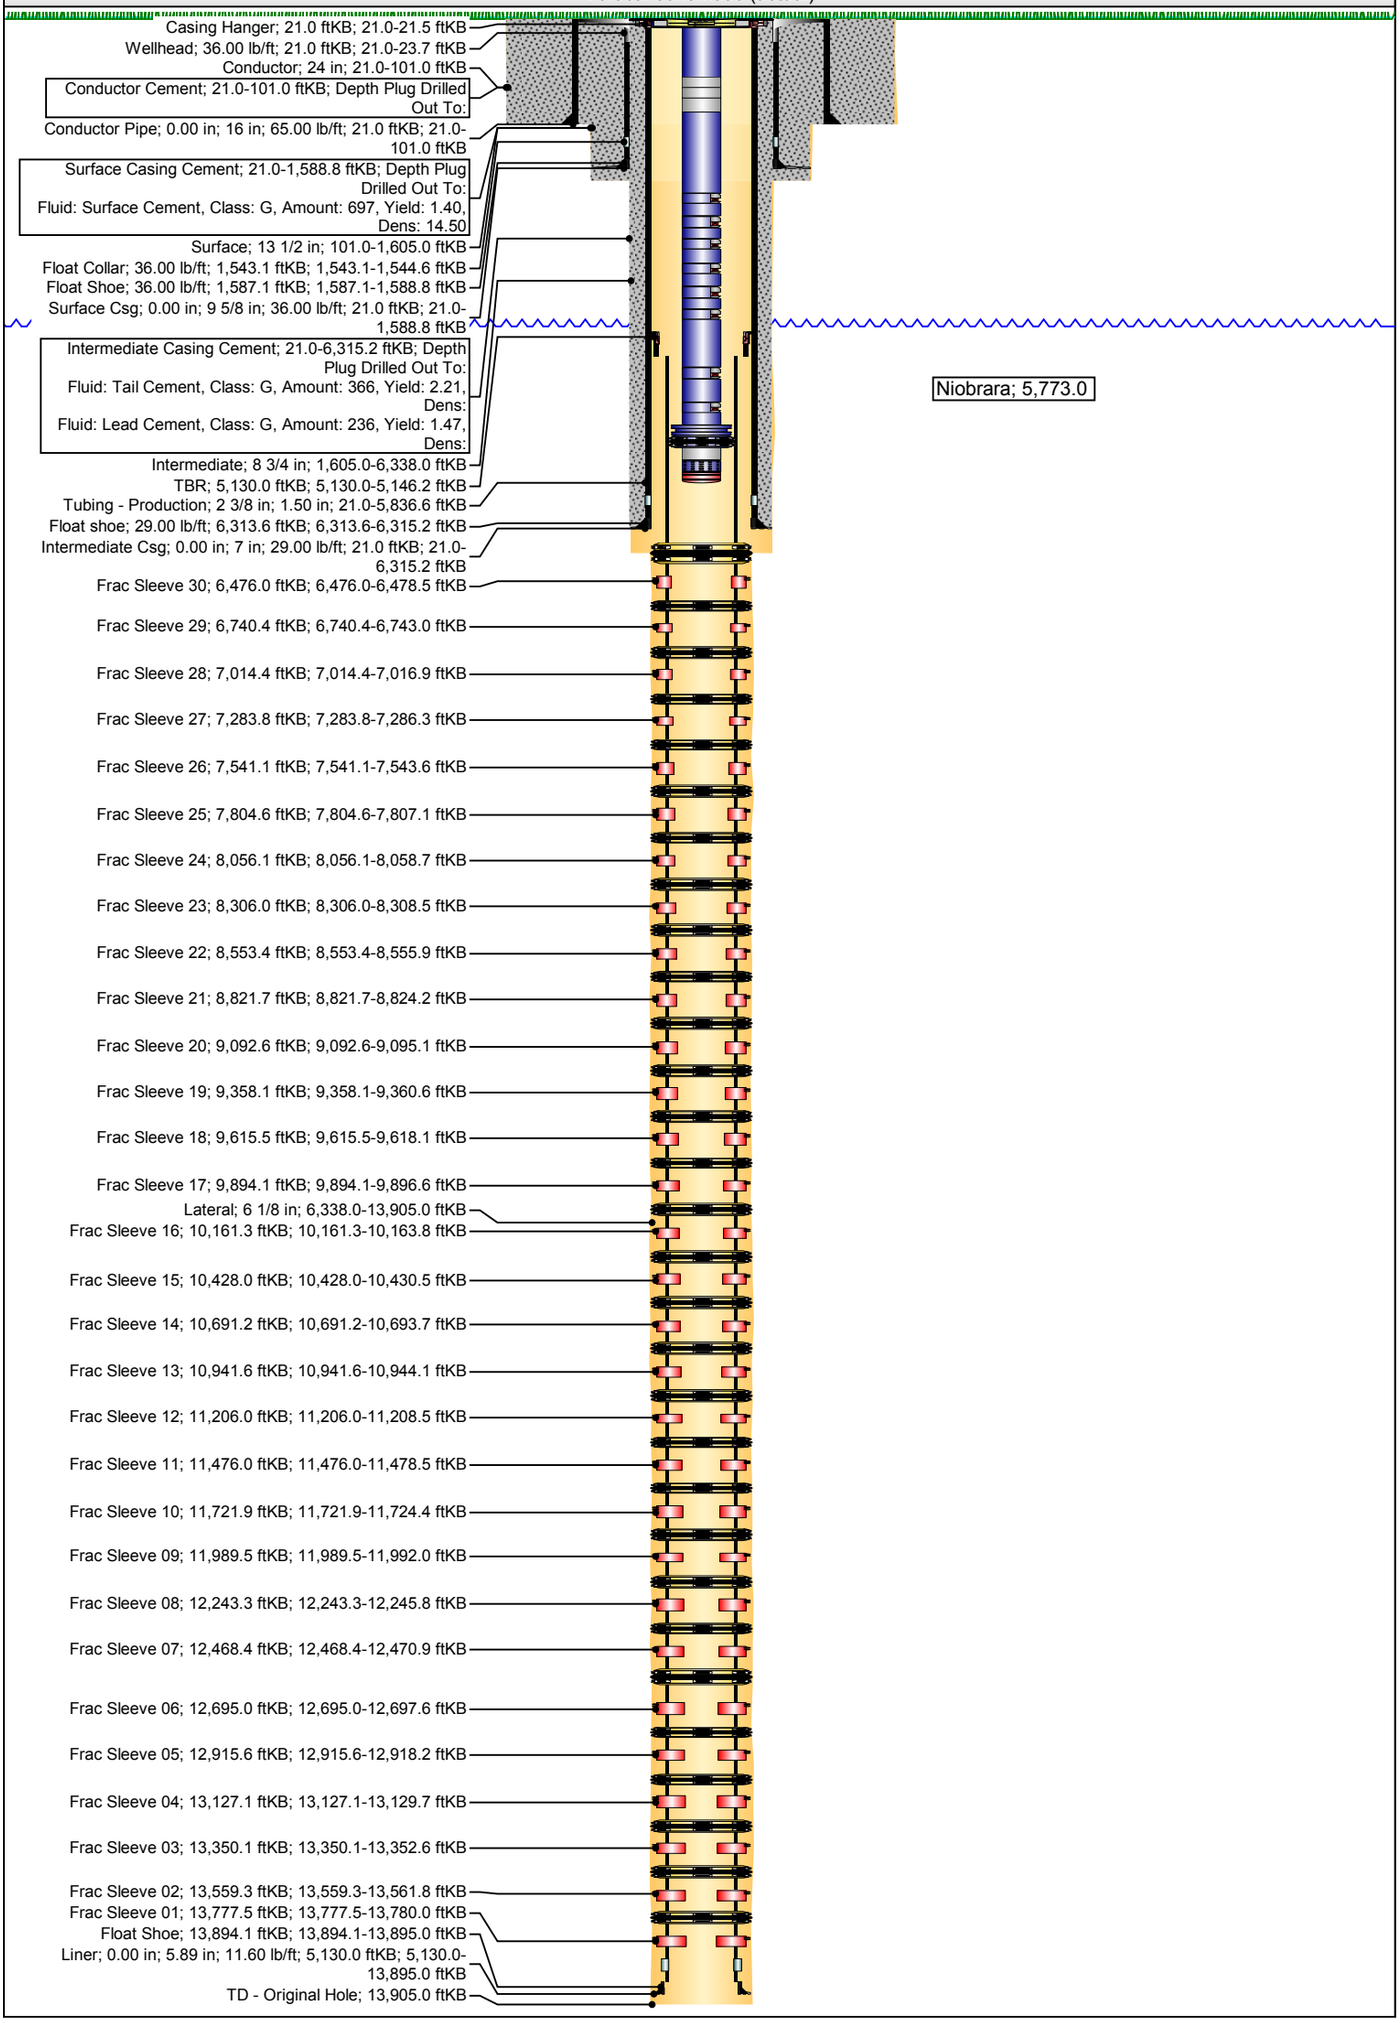

Report Date: 1/11/2016