

TIFFANY 1-1 PILOT


TOWNSHIP 33N, RANGE 7W

N.M.P.M.

SECTIONS 12 & 13

1280 Ac. BIA 14-20-604-2408 (LEASE)

+ parts of sections 14, 23 & 24

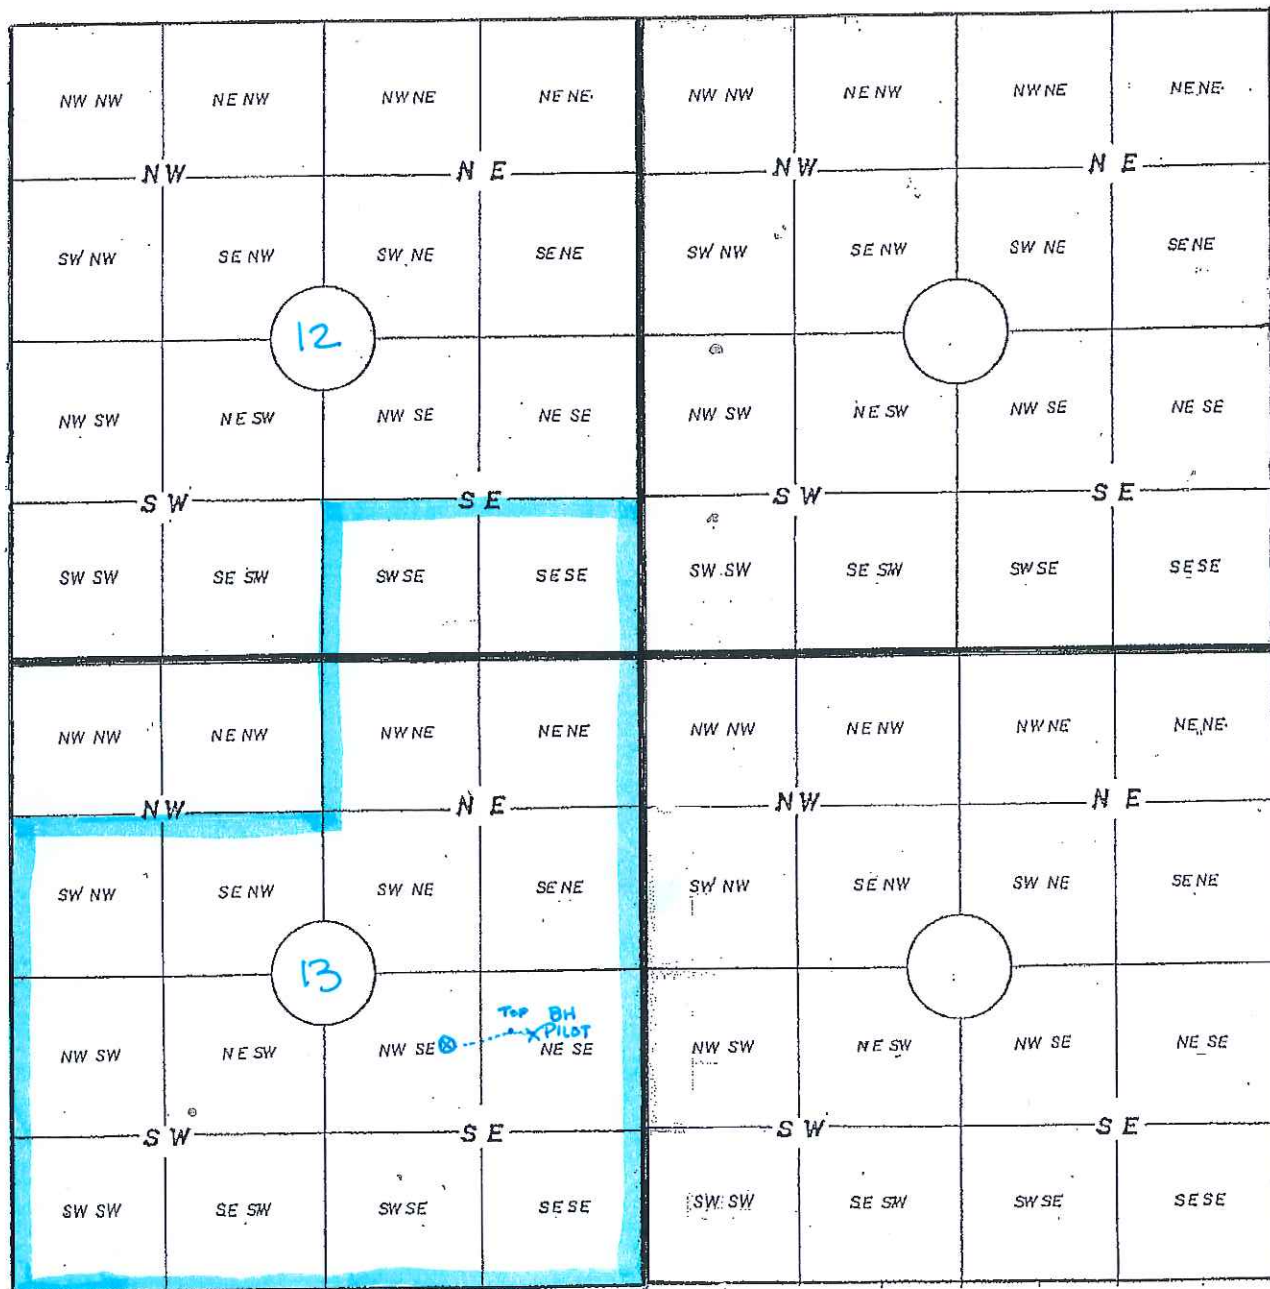

CLOSEST LEASE LINE TO PILOT BOTTOM
HOLE - 1019'