


Wellbore Schematic Input Report

Well Name: WELLS RANCH USX BB01-10

VERTICAL - ORIGINAL HOLE, 1/20/2016 7:43:43 AM

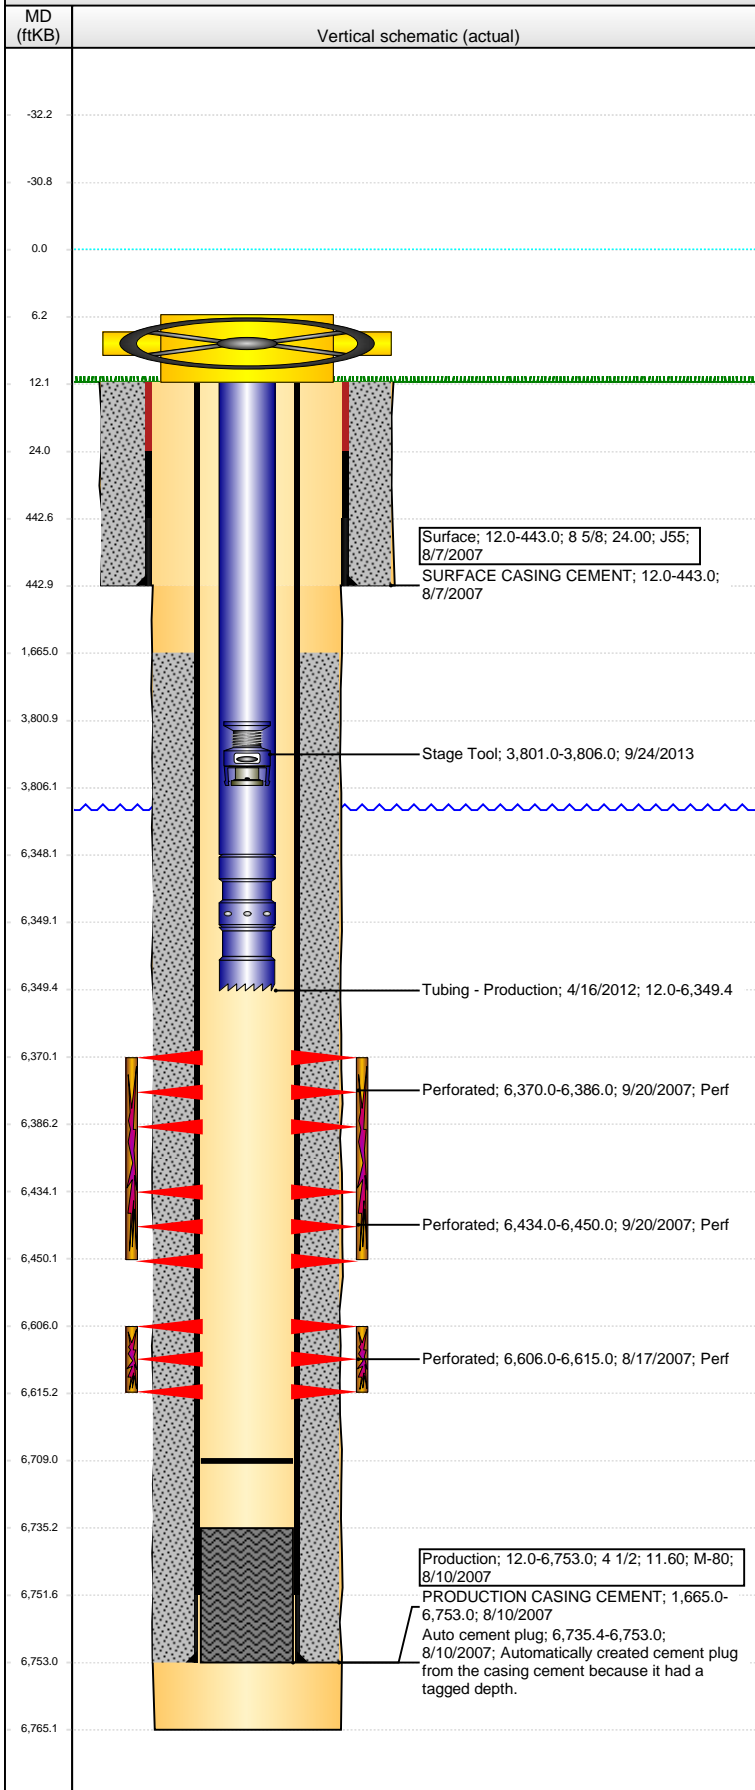

Well Header									
API 05-123-26131		Business Unit DJ BASIN		District 15		Well Config VERTICAL			
Original KB Elevation (ft) 4,691.00		KB - GL / MSL (ftKB) 12.00		Spud Date 8/7/2007		P & A Date			
Comment									
Directions To Well WCR 67 & WCR 68, SOUTH /SOUTH EAST 2.8 MILES TO COW CAMP, EAST 1.6 MILES, TO C.G. EAST 7/10, SOUTH 4/10, NW 1/10 INTO .									
Congressional Location									
Quarter 1	Quarter 2	Quarter 3	Quarter 4	Section	Township	Twnshp N...	Range	Rng E/W Dir	
		NW	SE	1	5	N	63	W	
Bottom Hole Location									
North-South Distance (ft)		From N or S Line		East-West Distance (ft)			From E or W Line		
Plug Back Total Depths									
Date	Depth (ftKB)	Method			Com				
8/9/2007	6,735.4	CASING TALLY			DRILLED UP CIFTP AND CHASED TO 6709' C/O DN W/217JTS & B/S.				
1/28/2008	6,709.0	TUBING TALLY							
4/13/2012	6,709.0	TUBING TALLY							
Wellbore Sections									
Section Des			Size (in)		Act Top, MD (ftKB)		Act Btm, MD (ftKB)		
SURFACE			12 1/4		12.0		443.0		
PRODUCTION			7 7/8		443.0		6,765.0		
Zone Statuses									
Zone Name		Status Date	Status	Fluid Type	Job	Prod Method			
CODELL		9/23/2007	PR		DRILLING/CO...				
NIOBRARA		9/23/2007	PR		DRILLING/CO...				
Casing Strings									
Surface, 443.0ftKB									
Casing Description		Run Date	OD (in)	Wt/Len (l...	Grade	Top, MD (ft...	MD (ftKB)		
Surface		8/7/2007	8 5/8	24.00	J55	12.0	443.0		
Production, 6,753.0ftKB									
Casing Description		Run Date	OD (in)	Wt/Len (l...	Grade	Top, MD (ft...	MD (ftKB)		
Production		8/10/2007	4 1/2	11.60	M-80	12.0	6,753.0		
Cement									
Description					Top Depth (ftKB)		Bottom Depth (ftKB)		
SURFACE CASING CEMENT					12.0		443.0		
Description					Top Depth (ftKB)		Bottom Depth (ftKB)		
PRODUCTION CASING CEMENT					1,665.0		6,753.0		
Tubing Strings									
Tubing Description		Run Date	String...	ID (in)	Wt (lb/ft)	Grade	Len (ft)	Set De...	
Tubing - Production		1/28/2008	2 3/8	1.995	4.70	J-55	6,583.37		
Tubing Description		Run Date	String...	ID (in)	Wt (lb/ft)	Grade	Len (ft)		
Tubing - Production		4/16/2012	2 3/8	1.995	4.70	J-55	6,337.44		
Tubing Components									
Item Des		OD (in)	Wt (lb/ft)	Grade	Jts	Len (ft)	Btm (ftKB)	Btm (TVD) (ftKB)	
Tubing		2 3/8	4.70	J-55	206	6,335.94	6,347.9		
Seal Nipple		2 3/8	4.70	J-55	1	1.17	6,349.1		
Notched collar		2 3/8	4.70	J-55	1	0.33	6,349.4		
Perforation Data									
Zone		Bnch/St g	Entered Shot Total	Top (ftKB)		Btm (ftKB)		Date	
NIOBRARA, ORIGINAL HOLE			64	6,370.00		6,386.00		9/20/2007	
NIOBRARA, ORIGINAL HOLE			64	6,434.00		6,450.00		9/20/2007	
CODELL, ORIGINAL HOLE			36	6,606.00		6,615.00		8/17/2007	
Stimulations & Treatments									
Date	Zone			Primary Job Type					
9/20/2007	CODELL, ORIGINAL HOLE			DRILLING/COMPLETION - ORIGINAL					
Technical Result			Tech Result Details			Tech Result Note			
Comment									

Well Name: WELLS RANCH USX BB01-10

VERTICAL - ORIGINAL HOLE, 1/20/2016 7:43:45 AM

Stimulations & Treatments

Date	Zone	Primary Job Type
9/20/2007	NIOBRARA, ORIGINAL HOLE	DRILLING/COMPLETION - ORIGINAL

Technical Result	Tech Result Details	Tech Result Note

Comment

Other In Hole

Run Date	Des	OD (in)	Top (ftKB)	Btm (ftKB)
9/24/2013	Stage Tool	2	3,801.0	3,806.0

Logs

Date	Type	Top, MD (ftKB)	Btm, MD (ftKB)
8/9/2007	Compensated Density	2,650.0	6,745.0
8/9/2007	Induction	443.0	6,766.0
8/16/2007	CBL/CCL/GR	1,550.0	6,710.0
10/2/2014	GYRO	10.0	6,250.0

