




XDR 20

Well:	Gregory 05-09H	Engineer:	Tyler McCullar
Field:	North Park	Manager:	Nick Newland
County:	Jackson County, CO	Geology:	Scott Cherry
Surface:	202' FSL & 71' FWL of 9-T7N-R80W	Production:	Jake Thomas
PBHL:	300' FNL & 350' FWL of 9-T7N-R80W	Land:	Rick Silman
GL:	8,091'	KB:	8,110'
		AFE #:	DC14578

Horizontal Well

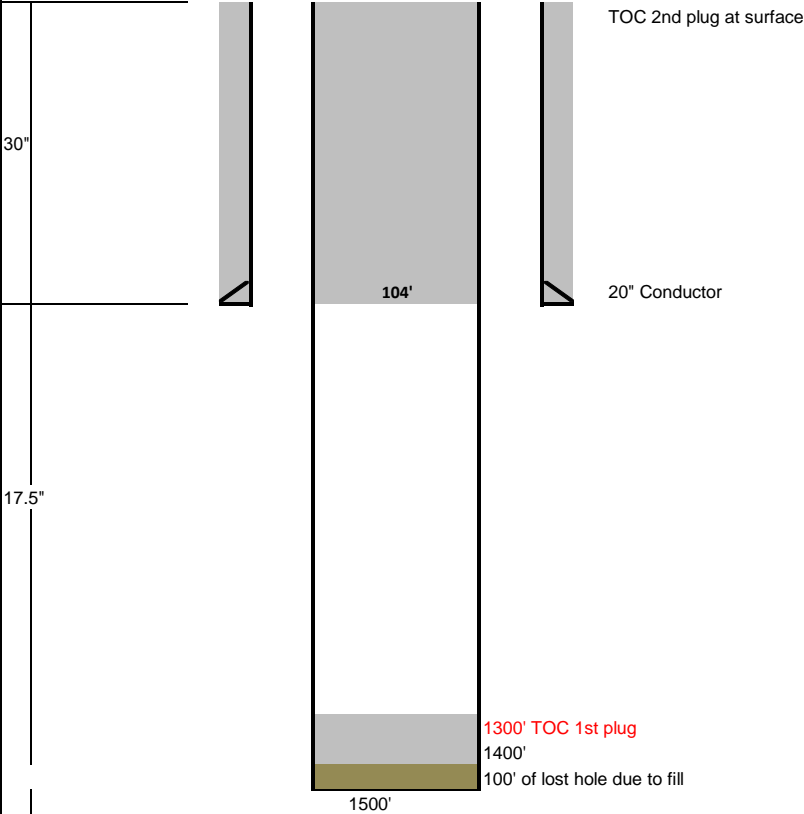

Wellhead Equipment	
Tubing Head	11" 5M X 7-1/16" 10M
B-Section	13-5/8" 5M X 11" 5M
A-Section	13-3/8" SOW x 13-5/8" 5M

Tubular Detail						
	Size	Wt	Grade	Conn	From	To
Wtr String	NA	NA	NA	NA	NA	NA
Surface	NA	NA	NA	NA	NA	NA
Intermediate	NA	NA	NA	NA	NA	NA
Production	NA	NA	NA	NA	NA	NA

Logging Program			
	Detail	From	To
Run #1	NA	NA	NA
Run #2	-	-	-

Directional Program	
KOP:	NA
Build:	NA
	NA
	NA
Tangent:	NA
Azimuth:	NA
EOB:	NA
Hold:	NA
TD:	NA
TD (X&Y):	NA

Prepared By	Date	Cementing	Liner Hanger	Mud Loggers	Mud Company	Directional
Tyler McCullar (405) 517-0411	1/21/2016	Schlumberger	NA	Toledo Mudlogging	MI Swaco	Baker Hughes
		Tim Muntzinger	NA	NA	John Pittman	Jason Weltin
		(405) 443-5708	NA	(866) 463-5600	(303) 909-4979	(209) 819-9418
		Logging Company	Fluid Disposal	Drill Pipe	Wellhead	
		ThruBit	Twin Enviro	NA	NOV	
		Hunter Bowering	NA	NA	Ryan Rother	
		(432) 528-4930	(970) 879-6985	NA	(405) 615-1927	