


# WELLBORE DIAGRAM

CURRENT WBD

990' FSL 990' FEL

Operator: Great Western Oil & Gas Co  
Well Name: State of Colorado AE 2  
Lease Number:  
Location: SESE 16 T 2S R63W  
Field: Cheifitan  
County, State: Adams, CO  
API Number: 05-001-07201-00  
Diagram Date: 1/19/2016  
Lat/Long 39.871241 -104.436289

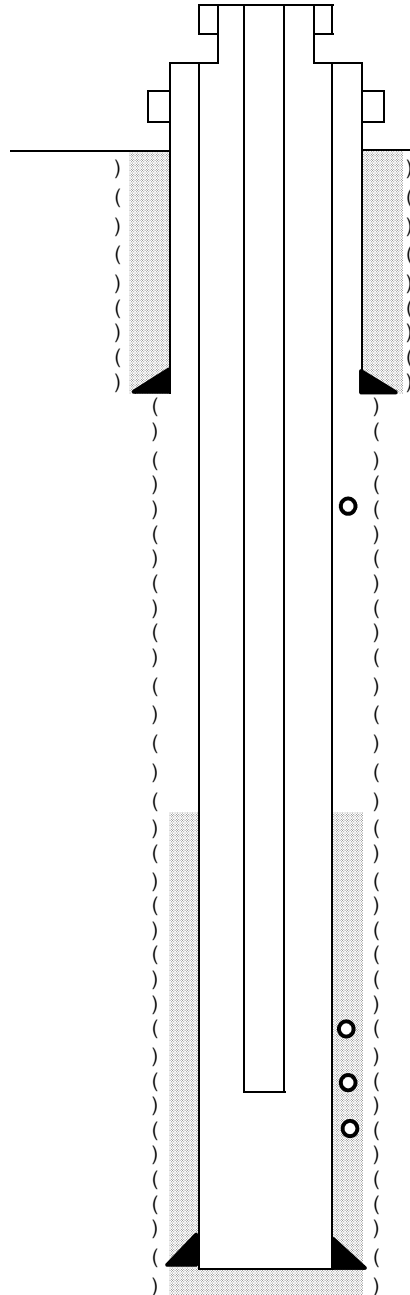

KB 5235 '

GL 5225 '

Spud Date:

1/20/1977

Fox Hills Base 1265  
Niobrara Top 6700  
J Sand Top 7570

12 1/4" Hole  
8 5/8" 24# set at 212'  
200 sx 'G' cement, 2.4% CaCl<sub>2</sub>, 1/4 Flocele/sx

Sliding Sleeve @ 1216'  
(no information on whether it was opened)

TOC: 5882'  
(Calculated)

J Sand Perfs: 7604 - 7645

7-7/8" Hole  
4-1/2", 10.5# set @ 7726'  
350 sx 50/50 pozmix cement, 2% gel, 10% salt

2-3/8" tubing set @ ?

PBTD = 7690  
TD = 7725