


NOTE: UNDER COLORADO LAW, YOU MUST COMMENCE ANY LEGAL ACTION BASED ON ANY DEFECT IN THIS CERTIFICATE WITHIN THREE YEARS AFTER DEFECT IS DISCOVERED, IN NO EVENT MAY ANY ACTION BASED UPON ANY DEFECT IN THIS SURVEY BE COMMENCED MORE THAN TEN YEARS AFTER DATE OF THIS CERTIFICATE SHOWN HEREON. (13-80105 C.R.S)

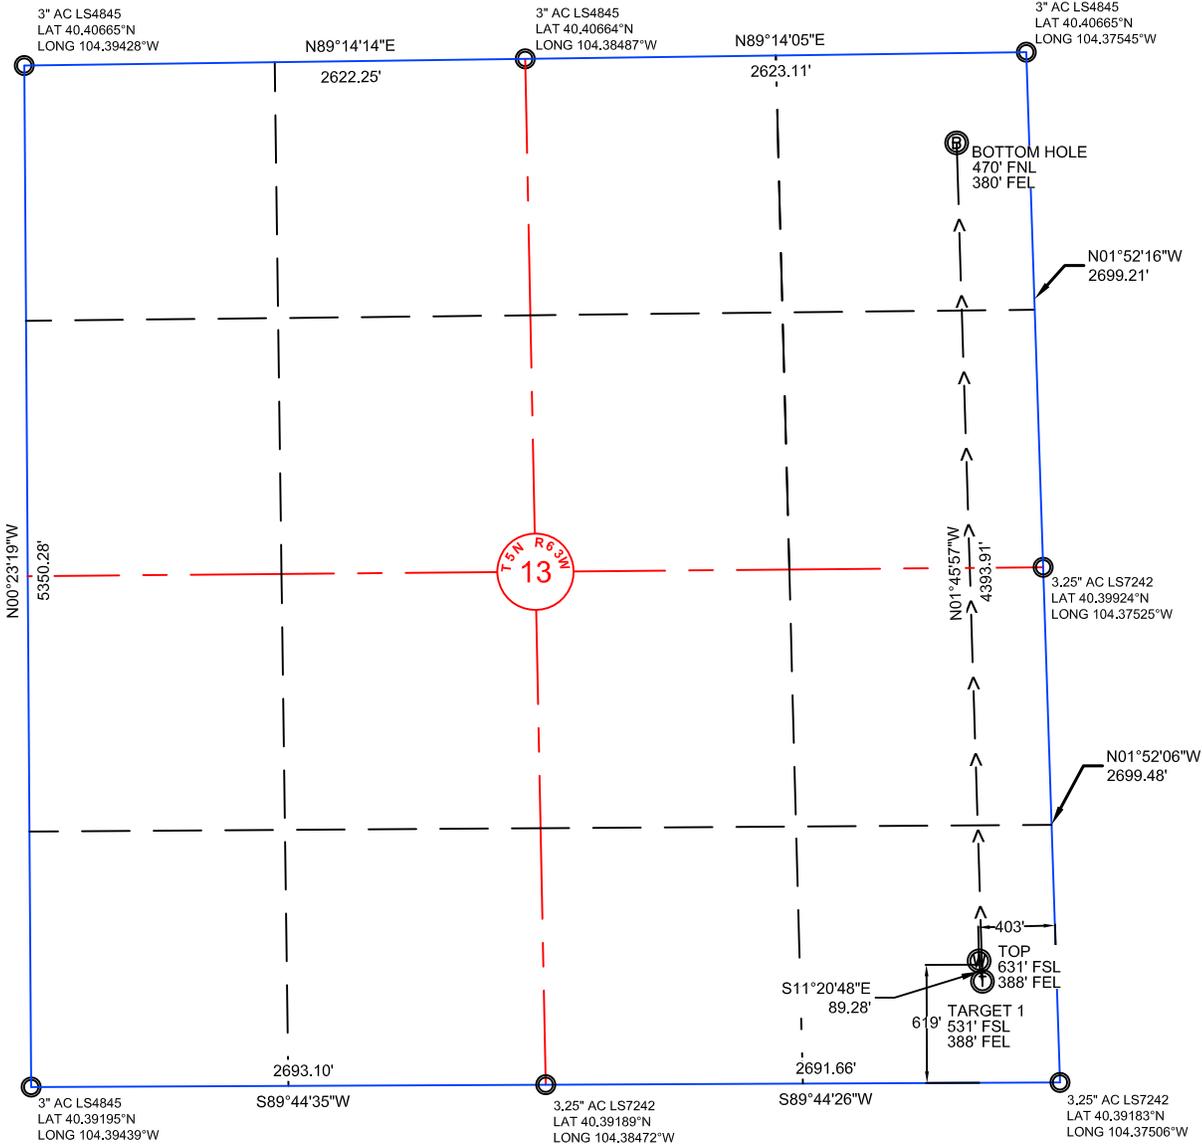

NOTES:

- ALL BEARINGS ARE GRID BASED UPON THE COLORADO STATE PLANE COORDINATE SYSTEM, NORTH ZONE, NAD83(2011) DERIVED FROM POST-PROCESSED STATIC GPS OBSERVATIONS.
- DISTANCES ARE ON GRID
- VERTICAL DATUM IS NAVD88 BASED UPON GPS OBSERVATIONS
- PDOP VALUE EQUALS 1.5.
- GPS OPERATOR: MIKE JOHNSON.
- UNDISTURBED GROUND ELEVATION AT WELLHEAD = 4596.8'
- ALL SECTION LENGTHS ARE MEASURED DISTANCES UNLESS NOTED BY (R), RECORD BEARING AND DISTANCE.
- NEAREST CULTURAL DISTANCES
 BUILDINGS: 1660' +/-
 BUILDING UNIT: 1660' +/-
 HIGH OCCUPANCY BUILDING UNIT: 5280'+
 DESIGNATED OUTSIDE ACTIVITY AREA: 5280'+
 PUBLIC ROAD: 5280'+
 ABOVE GROUND UTILITY: 1574' +/-
 RAILROAD: 5280'+
 PROPERTY LINE: 4774' +/-

CERTIFICATE OF SURVEYOR:


I, DAVID A. FEHRINGER OF LANDER, WYOMING HEREBY CERTIFY THAT THIS WELL LOCATION CERTIFICATE WAS PREPARED FROM NOTES TAKEN DURING AN ACTUAL SURVEY ON JANUARY 27, 2016; AND THAT IT CORRECTLY SHOWS THE DRILLING LOCATION OF BONANZA CREEK ENERGY, INC., NORTH PLATTE Y44-U41-13HNB AS STAKED DURING SAID SURVEY. THIS MAP DOES NOT REPRESENT A BOUNDARY SURVEY OR AN IMPROVEMENT LOCATION PLAT AND SHOULD NOT BE USED FOR THE ESTABLISHMENT OF BOUNDARY LINES.



4		NAD 83		STATE PLANE COORDINATES	
Y44-U41-13HNB	LATITUDE	LONGITUDE	NORTHING	EASTING	
SURFACE	40.39354	104.37655	1388188.01	3312913.99	
TARGET 1	40.39330	104.37649	1388100.47	3312931.56	
TOP	40.39357	104.37650	1388200.42	3312928.48	
BOTTOM HOLE	40.40536	104.37678	1392492.29	3312796.17	



Drawn By: MAM
 Checked By: DAF
 Date: 12-22-2014
 Revision: 4
 Date: 1-27-16
 Explanation: WELL AND PAD CHANGES

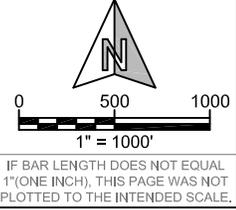

WELL LOCATION CERTIFICATE
 NORTH PLATTE
 Y44-U41-13HNB
 SE¼, SECTION 13,
 T.5N., R.63W., 6th PM
 WELD COUNTY, COLORADO

BONANZA CREEK
 410 17TH STREET
 DENVER, CO 80202
 (720) 440-6100

SHEET
 1
 OF
 1