WELLBORE SCHEMATIC

Citation Oil & Gas Corp.

OAP

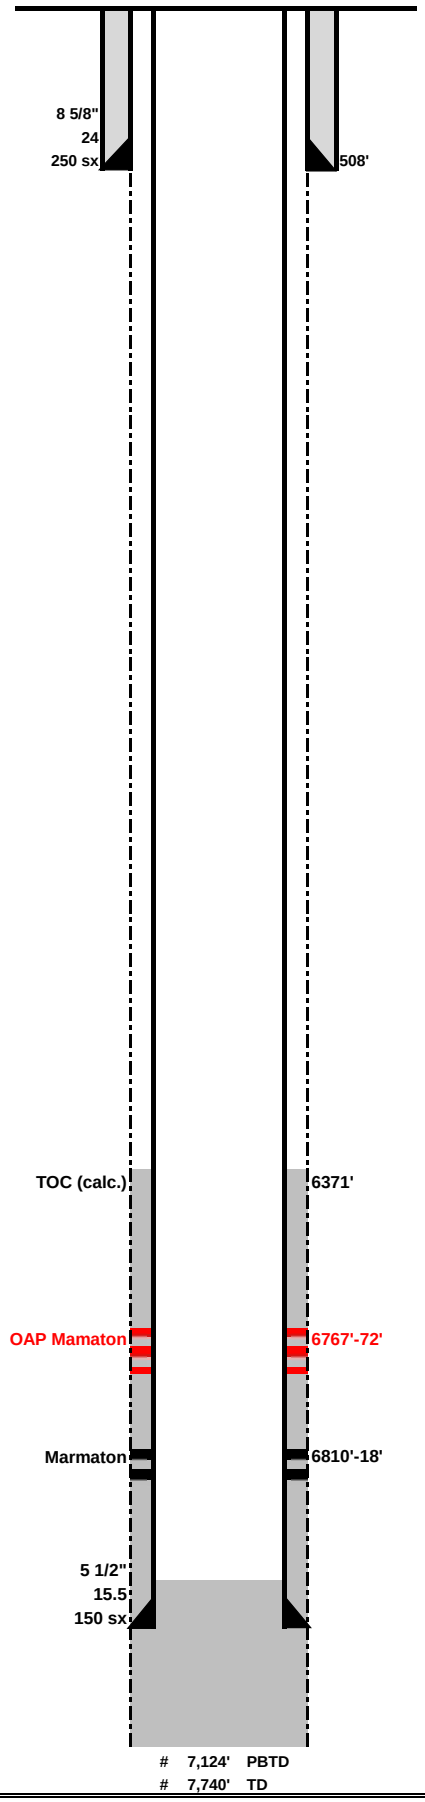

Lease:	**Fallow**	Well No.	**32-18 #1**
API No.	05-07306262	Status	PR
Location:	SWNE 18 10S 54W 6 PM		
County:	Lincoln	State: CO	Field: Fallow
TD	7740'	GL 5168'	Spud Date: 8/22/92
PBTD	7124'	KB 5177'	Comp Date: 9/21/92
Current Perfs/OH:	6767'-72', 6810'-18'	Current Zone:	Marmaton

Surface Equipment

Unit Make:	Unit Size:	
Unit S/N:	Unit Rotation:	
SPM:	Stroke Length:	Unit Sheave:
Prime Mover:		Motor Sheave:
Motor S/N:		Motor RPM:

Casing Breakdown

	Size	Grade / Wt	Depth	Cement
Surface	8 5/8"	24	508'	250 sx
Production	5 1/2"	15.5	7124'	150 sx
Liner				
Liner				
Liner				

Current Completion Assembly

Qty	Description	Footage
		TOTAL	**0.00'**

Rod Detail

Qty	Description	Footage
		TOTAL	**0.00'**

Comments

PREPARED BY: LL UPDATED: 2/4/2016

Citation OIL & GAS CORP.

M:\Sarah McKinney\Colorado\Fallow 32-18 1\Fallow WBD

WELLBORE SCHEMATIC	*Citation Oil & Gas Corp.*			
CURRENT	Lease:	**Fallow**	Well No.	**32-18 #1**
	API No.	05-07306262	Status	PR
	Location:	SWNE 18 10S 54W 6 PM		
	County:	Lincoln	State: CO	Field: Fallow
	TD	7740'	GL 5168'	Spud Date: 8/22/92
	PBTD	7124'	KB 5177'	Comp Date: 9/21/92
	Current Perfs/OH:	6810'-18'	Current Zone:	Marmaton

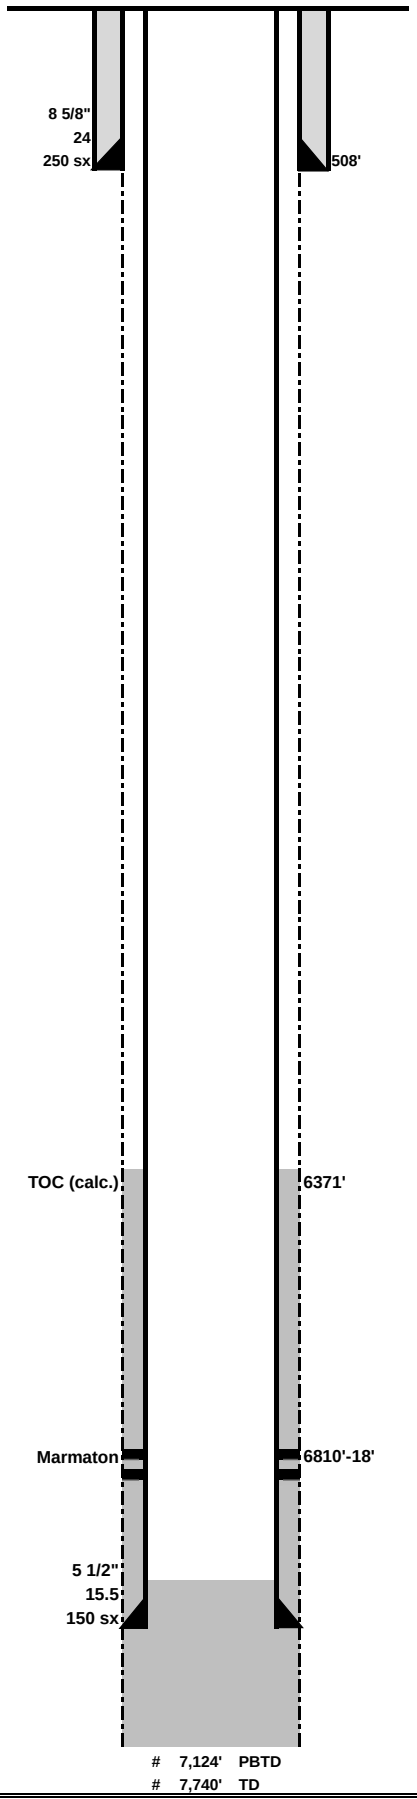

Surface Equipment

Unit Make:	Unit Size:	
Unit S/N:	Unit Rotation:	
SPM:	Stroke Length:	Unit Sheave:
Prime Mover:		Motor Sheave:
Motor S/N:		Motor RPM:

Casing Breakdown

	Size	Grade / Wt	Depth	Cement
Surface	8 5/8"	24	508'	250 sx
Production	5 1/2"	15.5	7124'	150 sx
Liner				
Liner				
Liner				

Current Completion Assembly

Qty	Description	Footage
	TOTAL	**0.00'**

Rod Detail

Qty	Description	Footage
	TOTAL	**0.00'**

Comments

PREPARED BY:	LL	UPDATED:	2/4/2016