




# Topographic Spill Map

## Willys 32-8 Spill

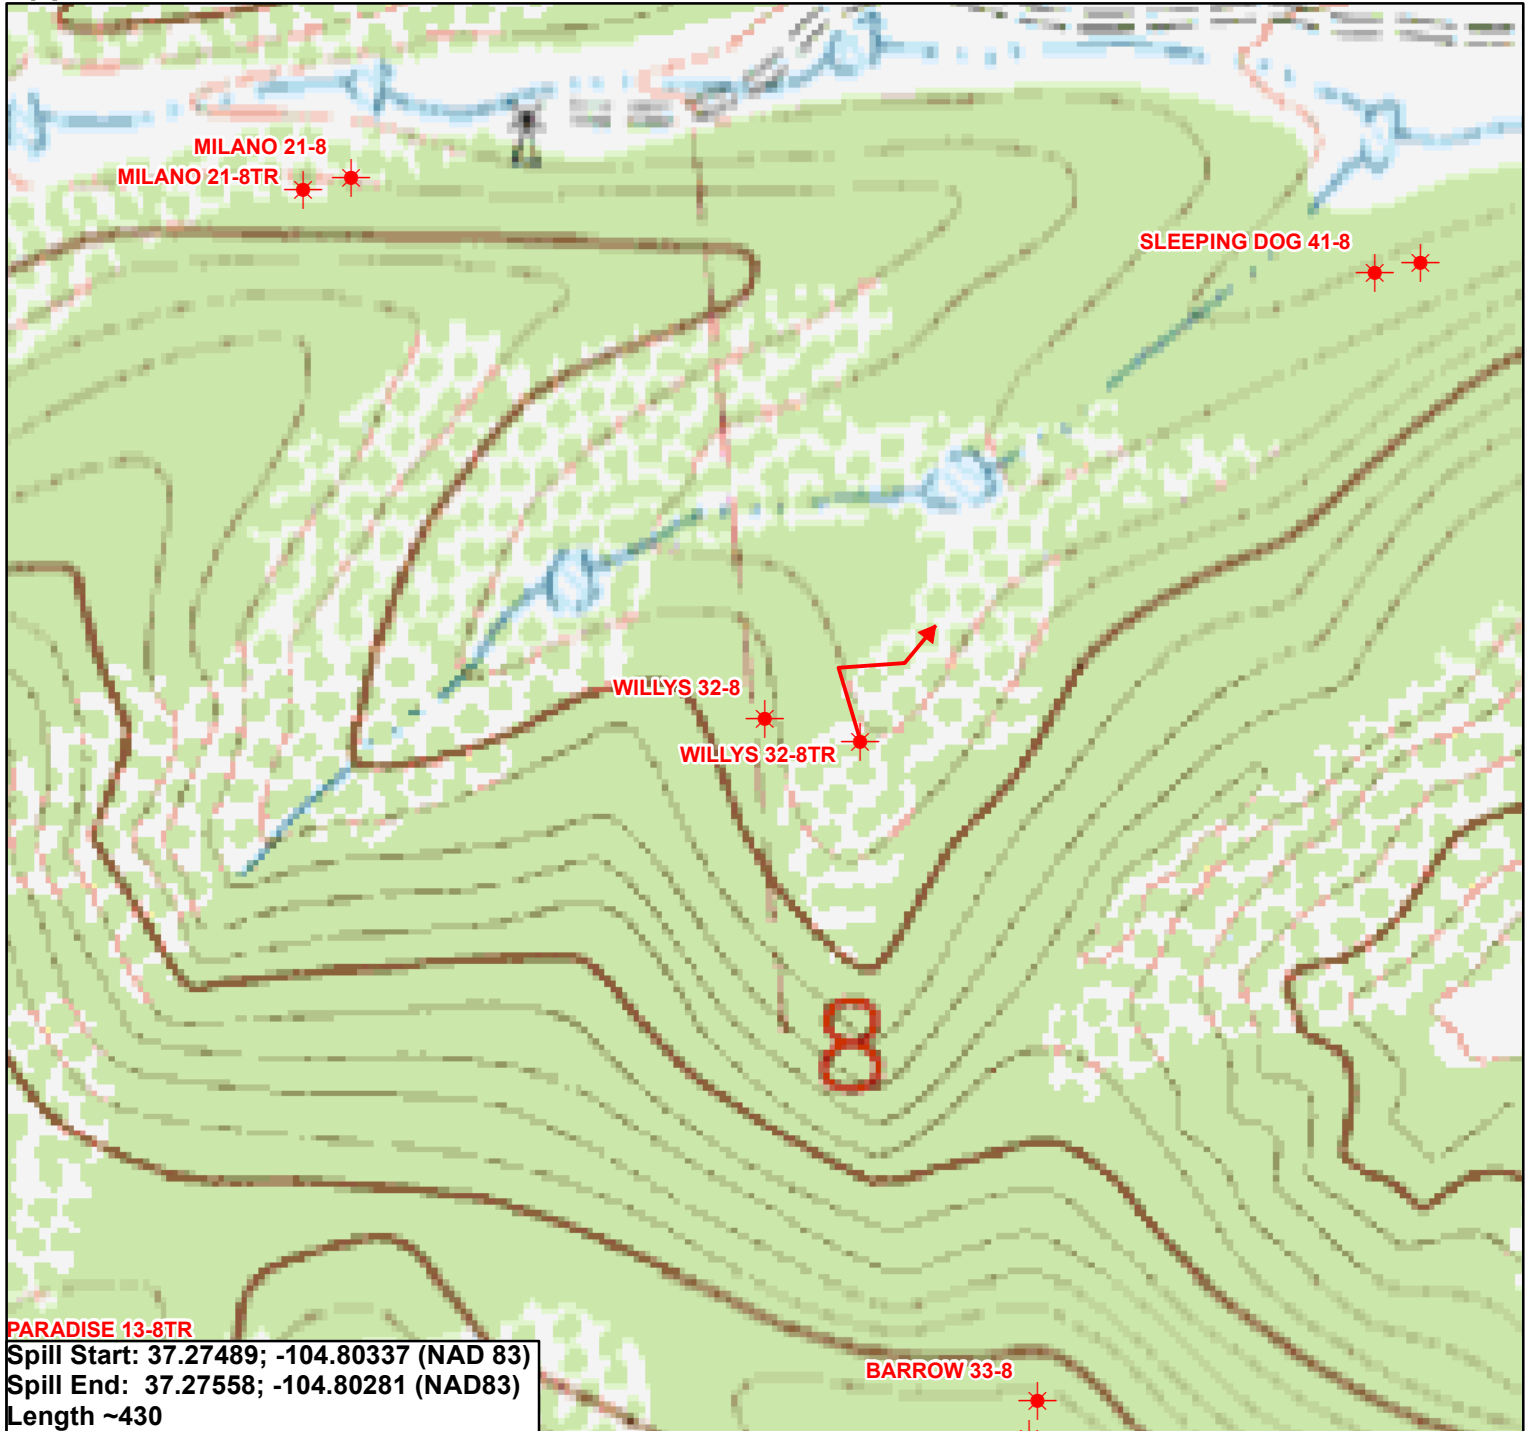

★ Permitted Well

→ Spill Path

0 250 500 750 1,000 Feet

1:5,000