Union Pacific 72X31
Plugged and Abandoned Wellbore

01/27/16

KB: 5307
GL: 5295

Conductor
0
0

Surface
10-3/4", 45.5#/ft, H-40
0 - 776'

Production
7", 23 #/ft, J-55
0 - 5373'

7", 23 #/ft, N-80
5373' - 6215'

-
-

Liner
-
-

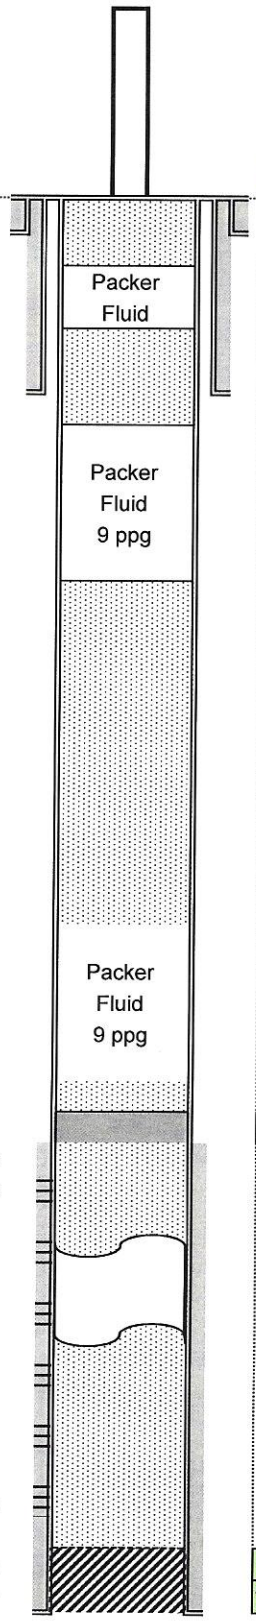

Weber Top: 5506
Top Perf: 5636

Bottom Perf: 6170

PBTD: 6200
TD: 6287

Cement Plug	Depths	BBls	Sxs
Surface Plug	0 - 50'	3	15
10 3/4" 40.5 #/ft x 7"	0 - 60'	3	15
Shoe & Annular Plugs			
7", 23#/ft	726 - 826'	4	19
10 3/4" 40.5 #/ft x 7"	726 - 826'	5	25
Intermediate Plug			
7", 23#/ft	3030 - 3180'	6	29
above CICR	5370 - 5470'	2	9
7" CICR:	5470		
TOC: 5540			
Full Plug to PBTD Excess = 10%/1000'	5470 - 6200'	20	98
		BBls	Sxs
Total Cement required		43	208

Notes:
1-
2-